


PLAN # 17-E-8089 - CITY LINE PLAN ON RECORD
 WITH THE FITCHBURG PUBLIC WORKS DEPT.

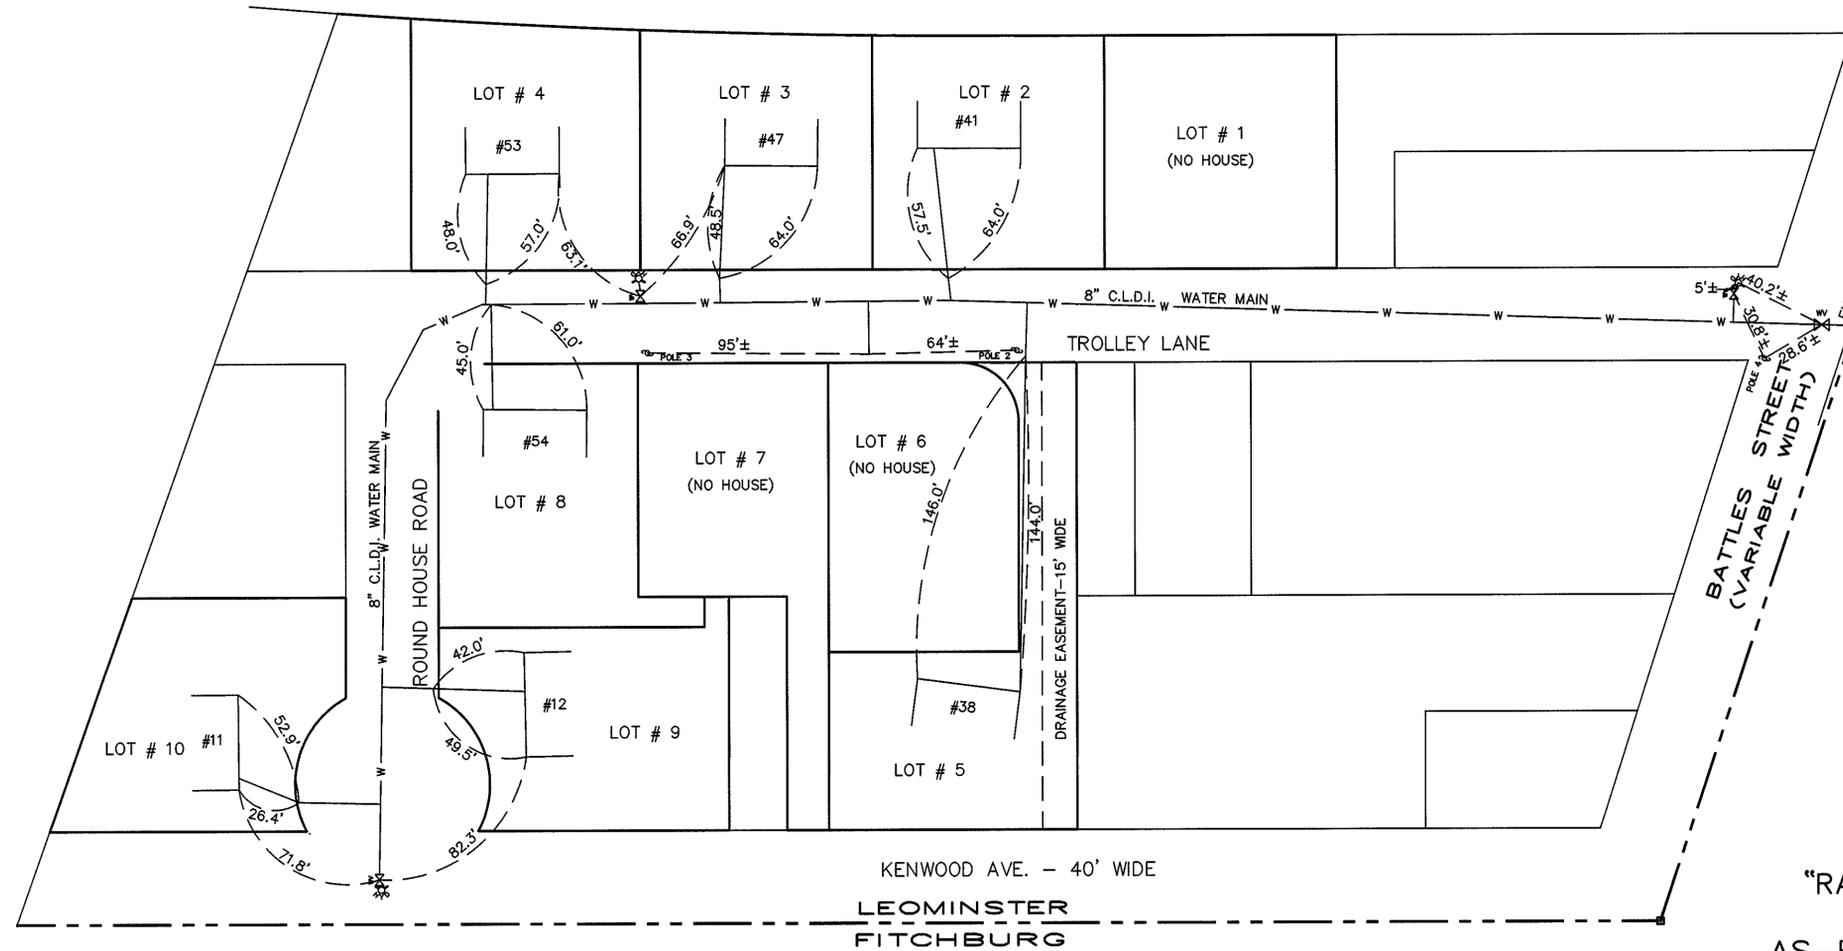

LEOMINSTER
 FITCHBURG
 EXISTING 12" WATER MAIN
 BATTLES STREET (VARIABLE WIDTH)

"RAILROAD CROSSING"
 AS-BUILT WATER PLAN
 LAND IN LEOMINSTER, MASS.

TROLLEY LANE & ROUND HOUSE ROAD

NOVEMBER 26, 1997



WHITMAN & BINGHAM ASSOCIATES, INC.
 REGISTERED PROFESSIONAL ENGINEERS & LAND SURVEYORS
 510 MECHANIC STREET - LEOMINSTER, MASSACHUSETTS 01453
 24-D-21A

NOTE: TIES TO SERVICE BOXES
 ARE TAKEN FROM RECORDS OF THE
 LEOMINSTER DEPARTMENT OF PUBLIC WORKS.

