
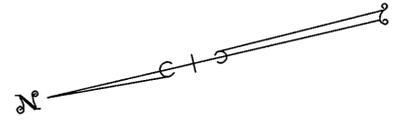


SEE SHEET 3

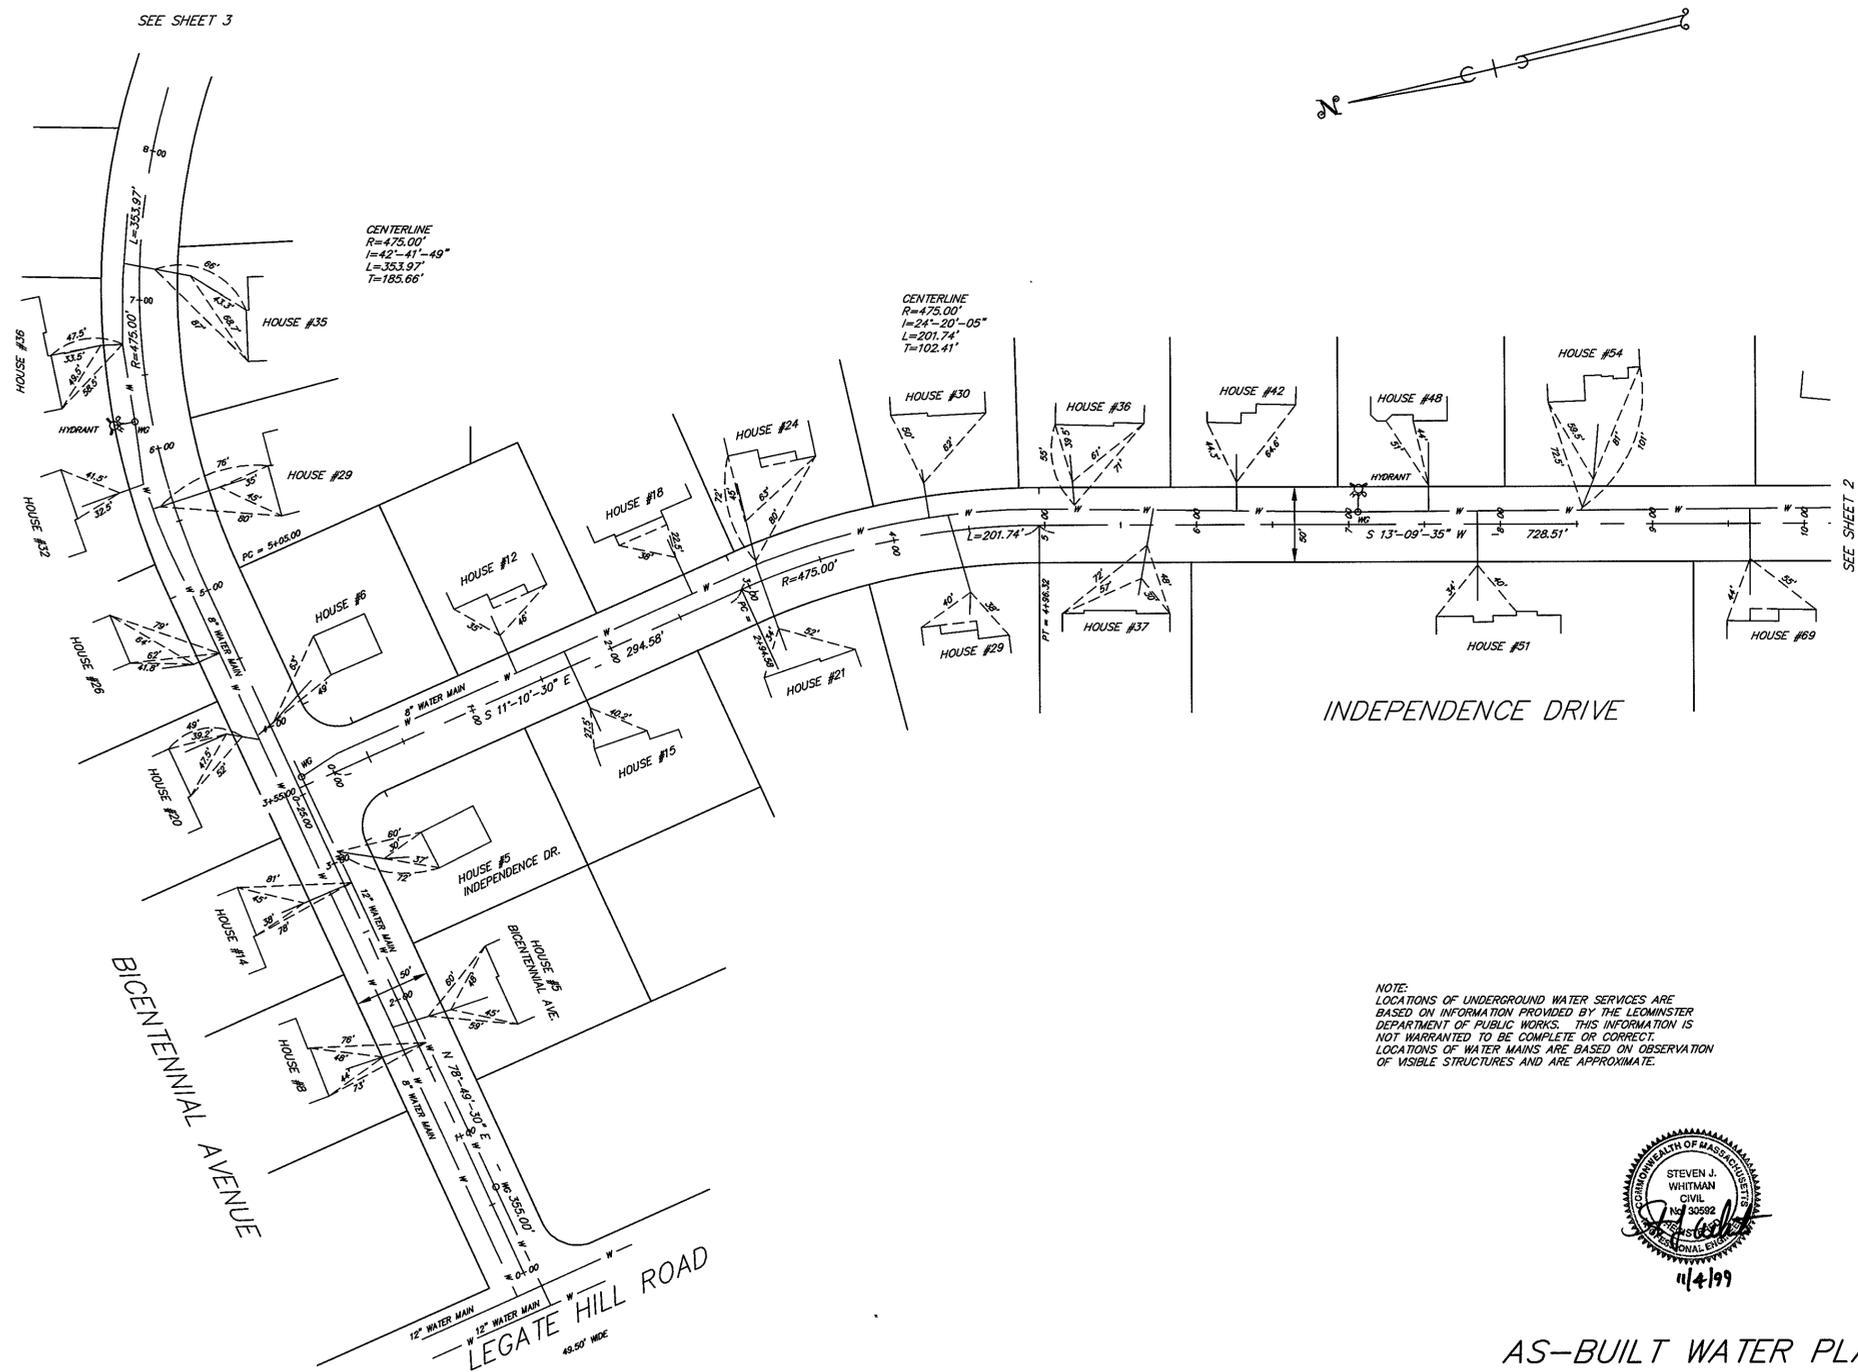

INDEPENDENCE DRIVE

BICENTENNIAL AVENUE

LEGATE HILL ROAD

NOTE:
LOCATIONS OF UNDERGROUND WATER SERVICES ARE
BASED ON INFORMATION PROVIDED BY THE LEOMINSTER
DEPARTMENT OF PUBLIC WORKS. THIS INFORMATION IS
NOT WARRANTED TO BE COMPLETE OR CORRECT.
LOCATIONS OF WATER MAINS ARE BASED ON OBSERVATION
OF VISIBLE STRUCTURES AND ARE APPROXIMATE.



AS-BUILT WATER PLAN
OF
INDEPENDENCE DRIVE, WEKEPEKE WAY,
BICENTENNIAL AVENUE, FLINTLOCK ROAD,
INDIAN RIDGE DRIVE & DRUMMER LANE

LEOMINSTER, MASS.
OCTOBER 27, 1999



WHITMAN & BINGHAM ASSOCIATES, INC.
REGISTERED PROFESSIONAL ENGINEERS & LAND SURVEYORS
510 MECHANIC STREET - LEOMINSTER, MASSACHUSETTS 01453

SHEET 1 OF 4 SHEETS

861
PLAN 21-D-8