D-318

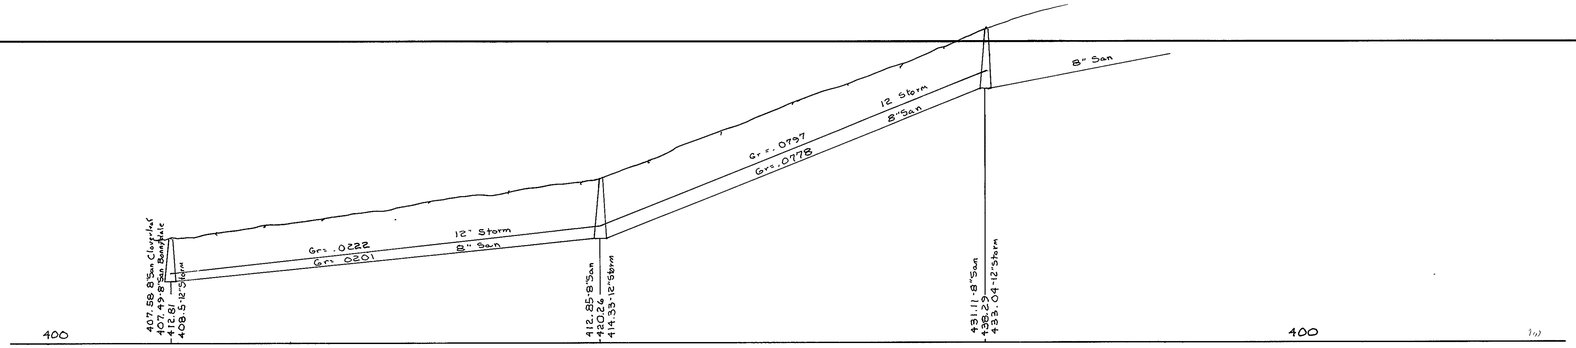

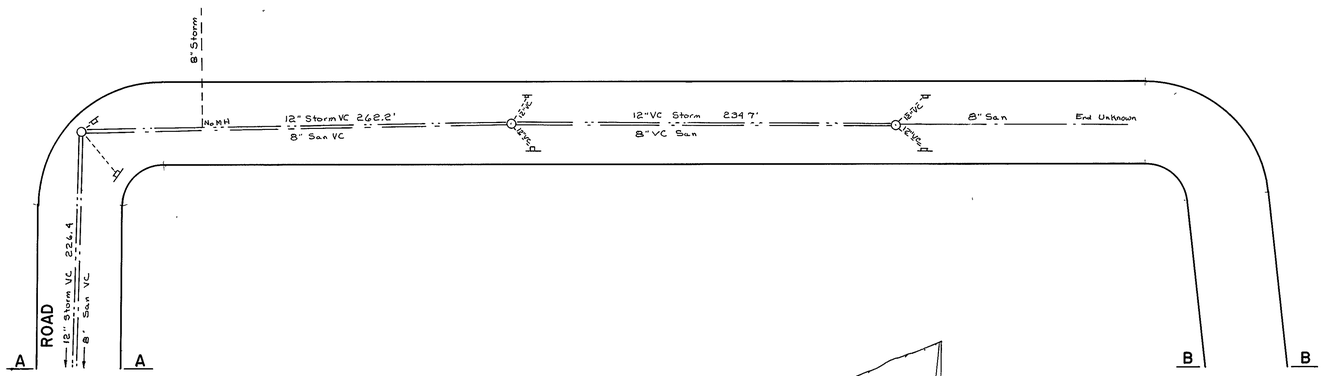

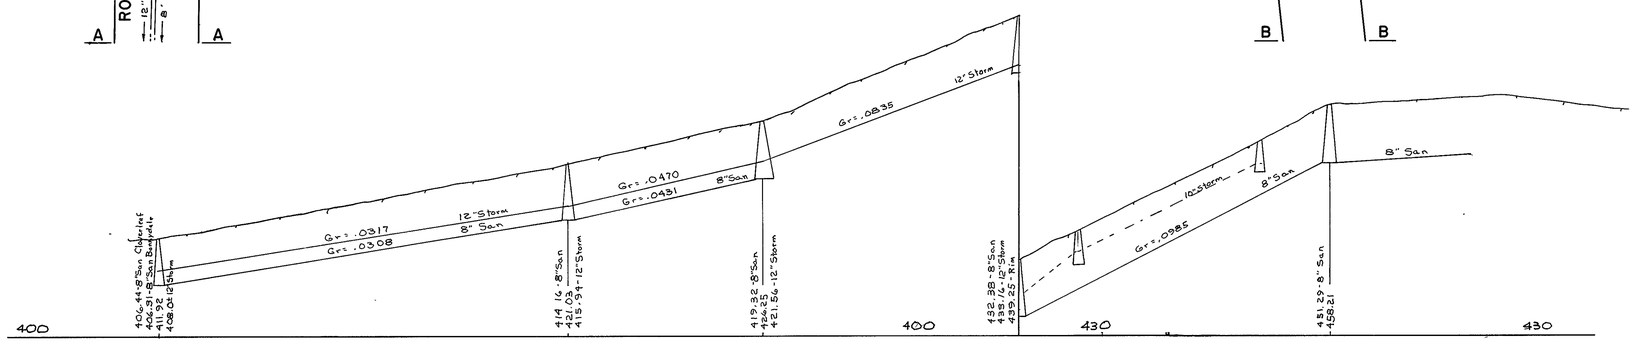

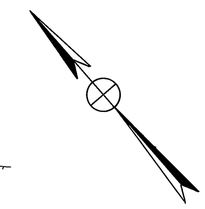

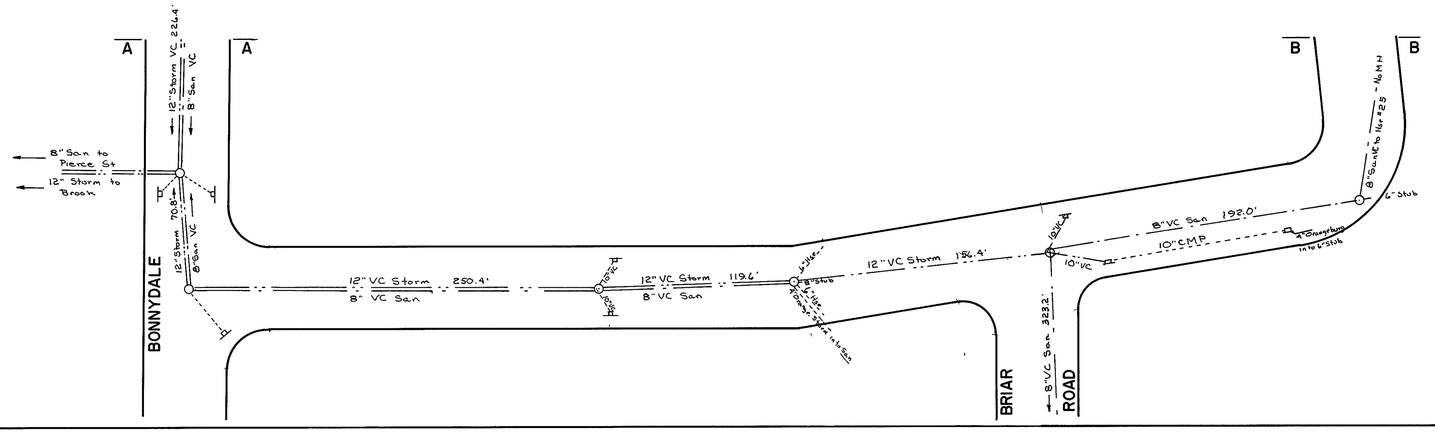

CITY OF LEOMINSTER, MASS.

DEPARTMENT OF PUBLIC WORKS

ENGINEERING DIVISION

SEWERS

CLOVER LEAF ROAD

PLAN AND PROFILE

SCALES: HOR. 1" = 40' VERT 1" = 8'

AS-BUILT 4-78

Bk 5 Pg 63