D-320

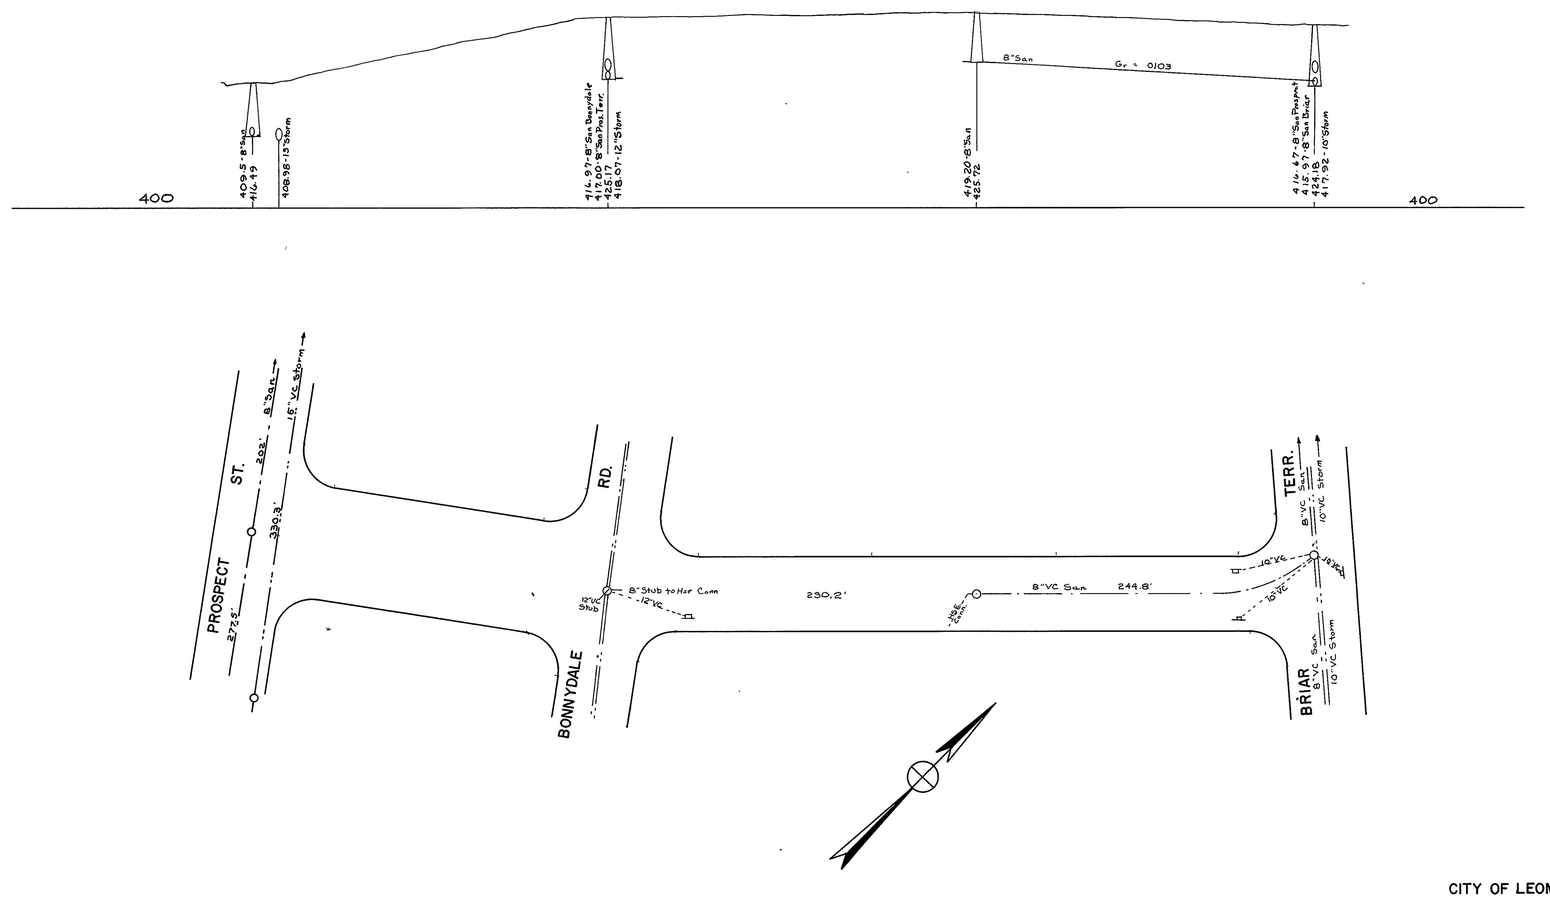

CITY OF LEOMINSTER, MASS.

DEPARTMENT OF PUBLIC WORKS

ENGINEERING DIVISION

SEWERS

PROSPECT TERRACE

PLAN AND PROFILE

SCALES: HORZ 1"=40' VERT. 1"=8'

AS-BUILT 4-78