D-321

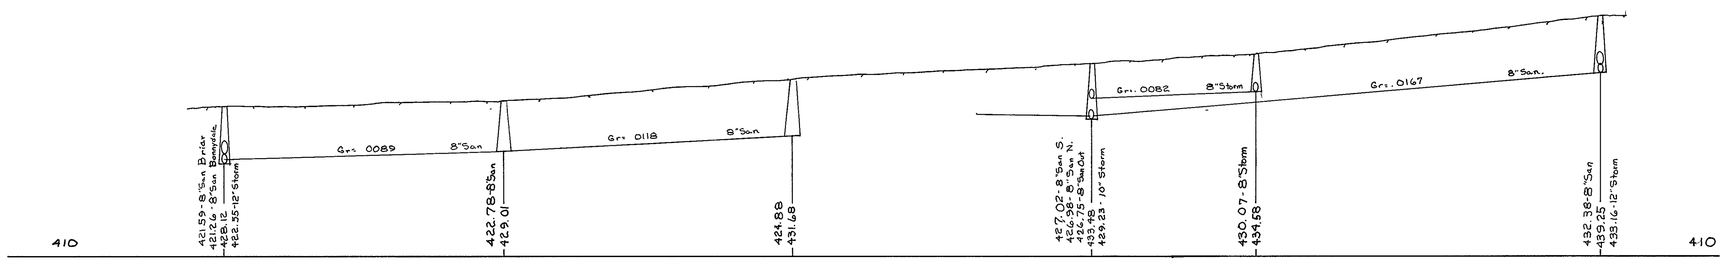


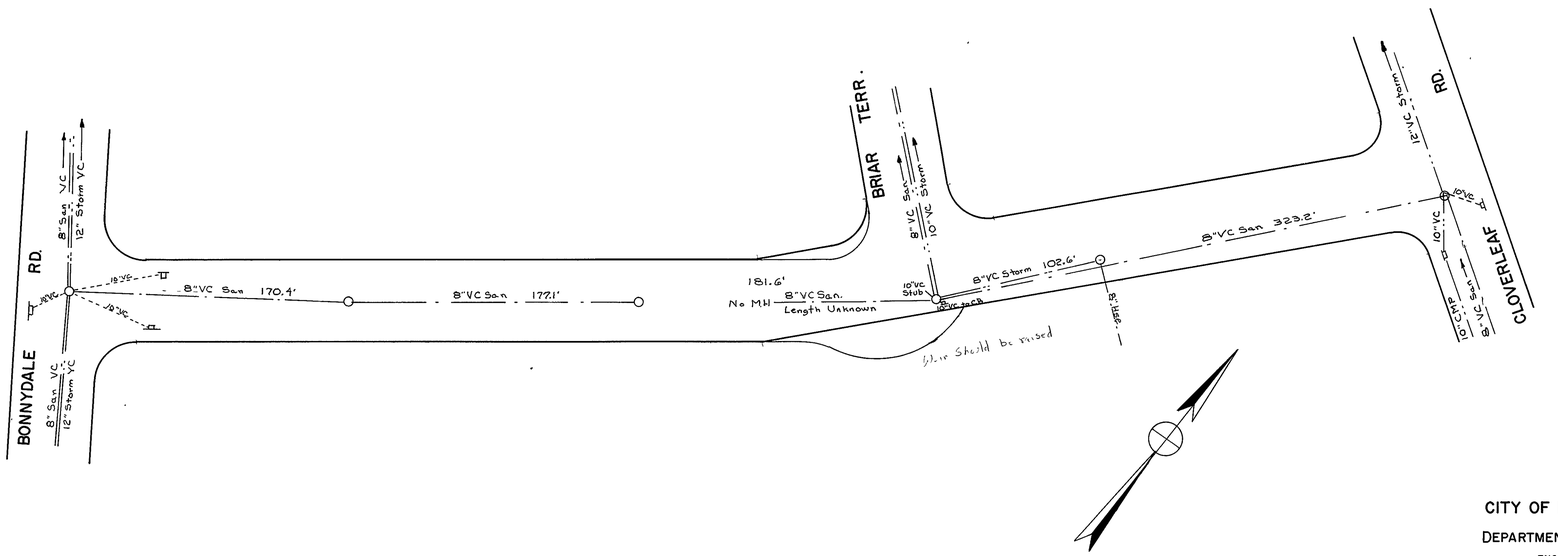


CITY OF LEOMINSTER, MASS.

DEPARTMENT OF PUBLIC WORKS

ENGINEERING DIVISION

SEWERS

# BRIAR ROAD

## PLAN AND PROFILE

SCALES: HORZ 1"= 40' VERT. 1"=8'

AS-BUILT 4-78

Bk 5 Pg 52