D-322

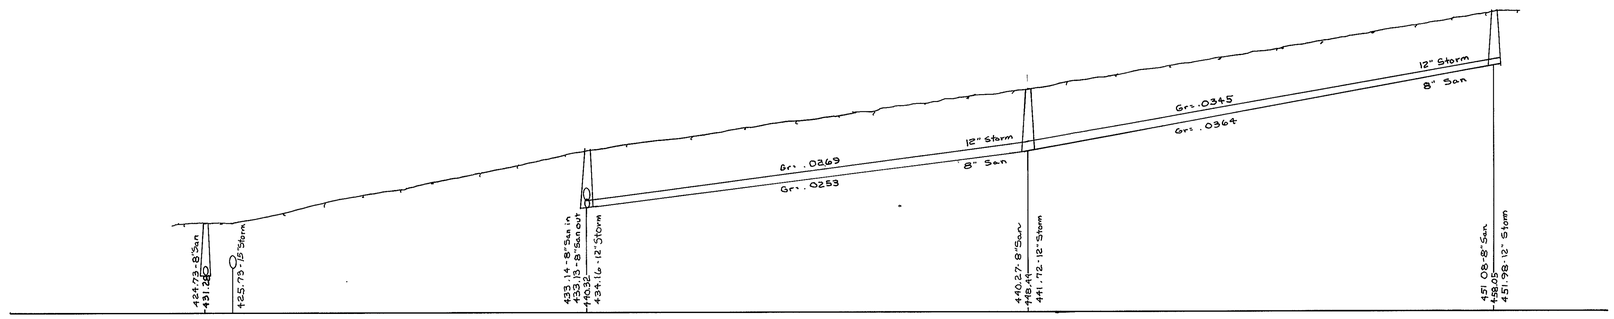

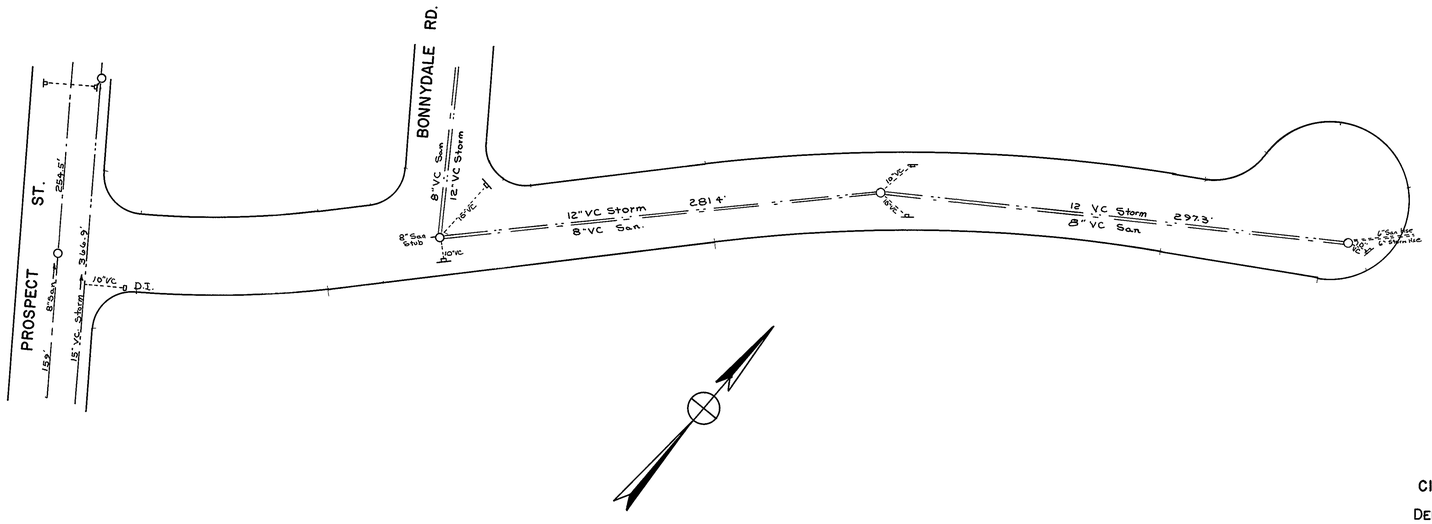

CITY OF LEOMINSTER, MASS.

DEPARTMENT OF PUBLIC WORKS

ENGINEERING DIVISION

SEWERS

CRESCENT ROAD

PLAN AND PROFILE

SCALES: HORZ 1"=40' VERT. 1"=8'

AS-BUILT 4-77

BK 5 Pg 52