D-343

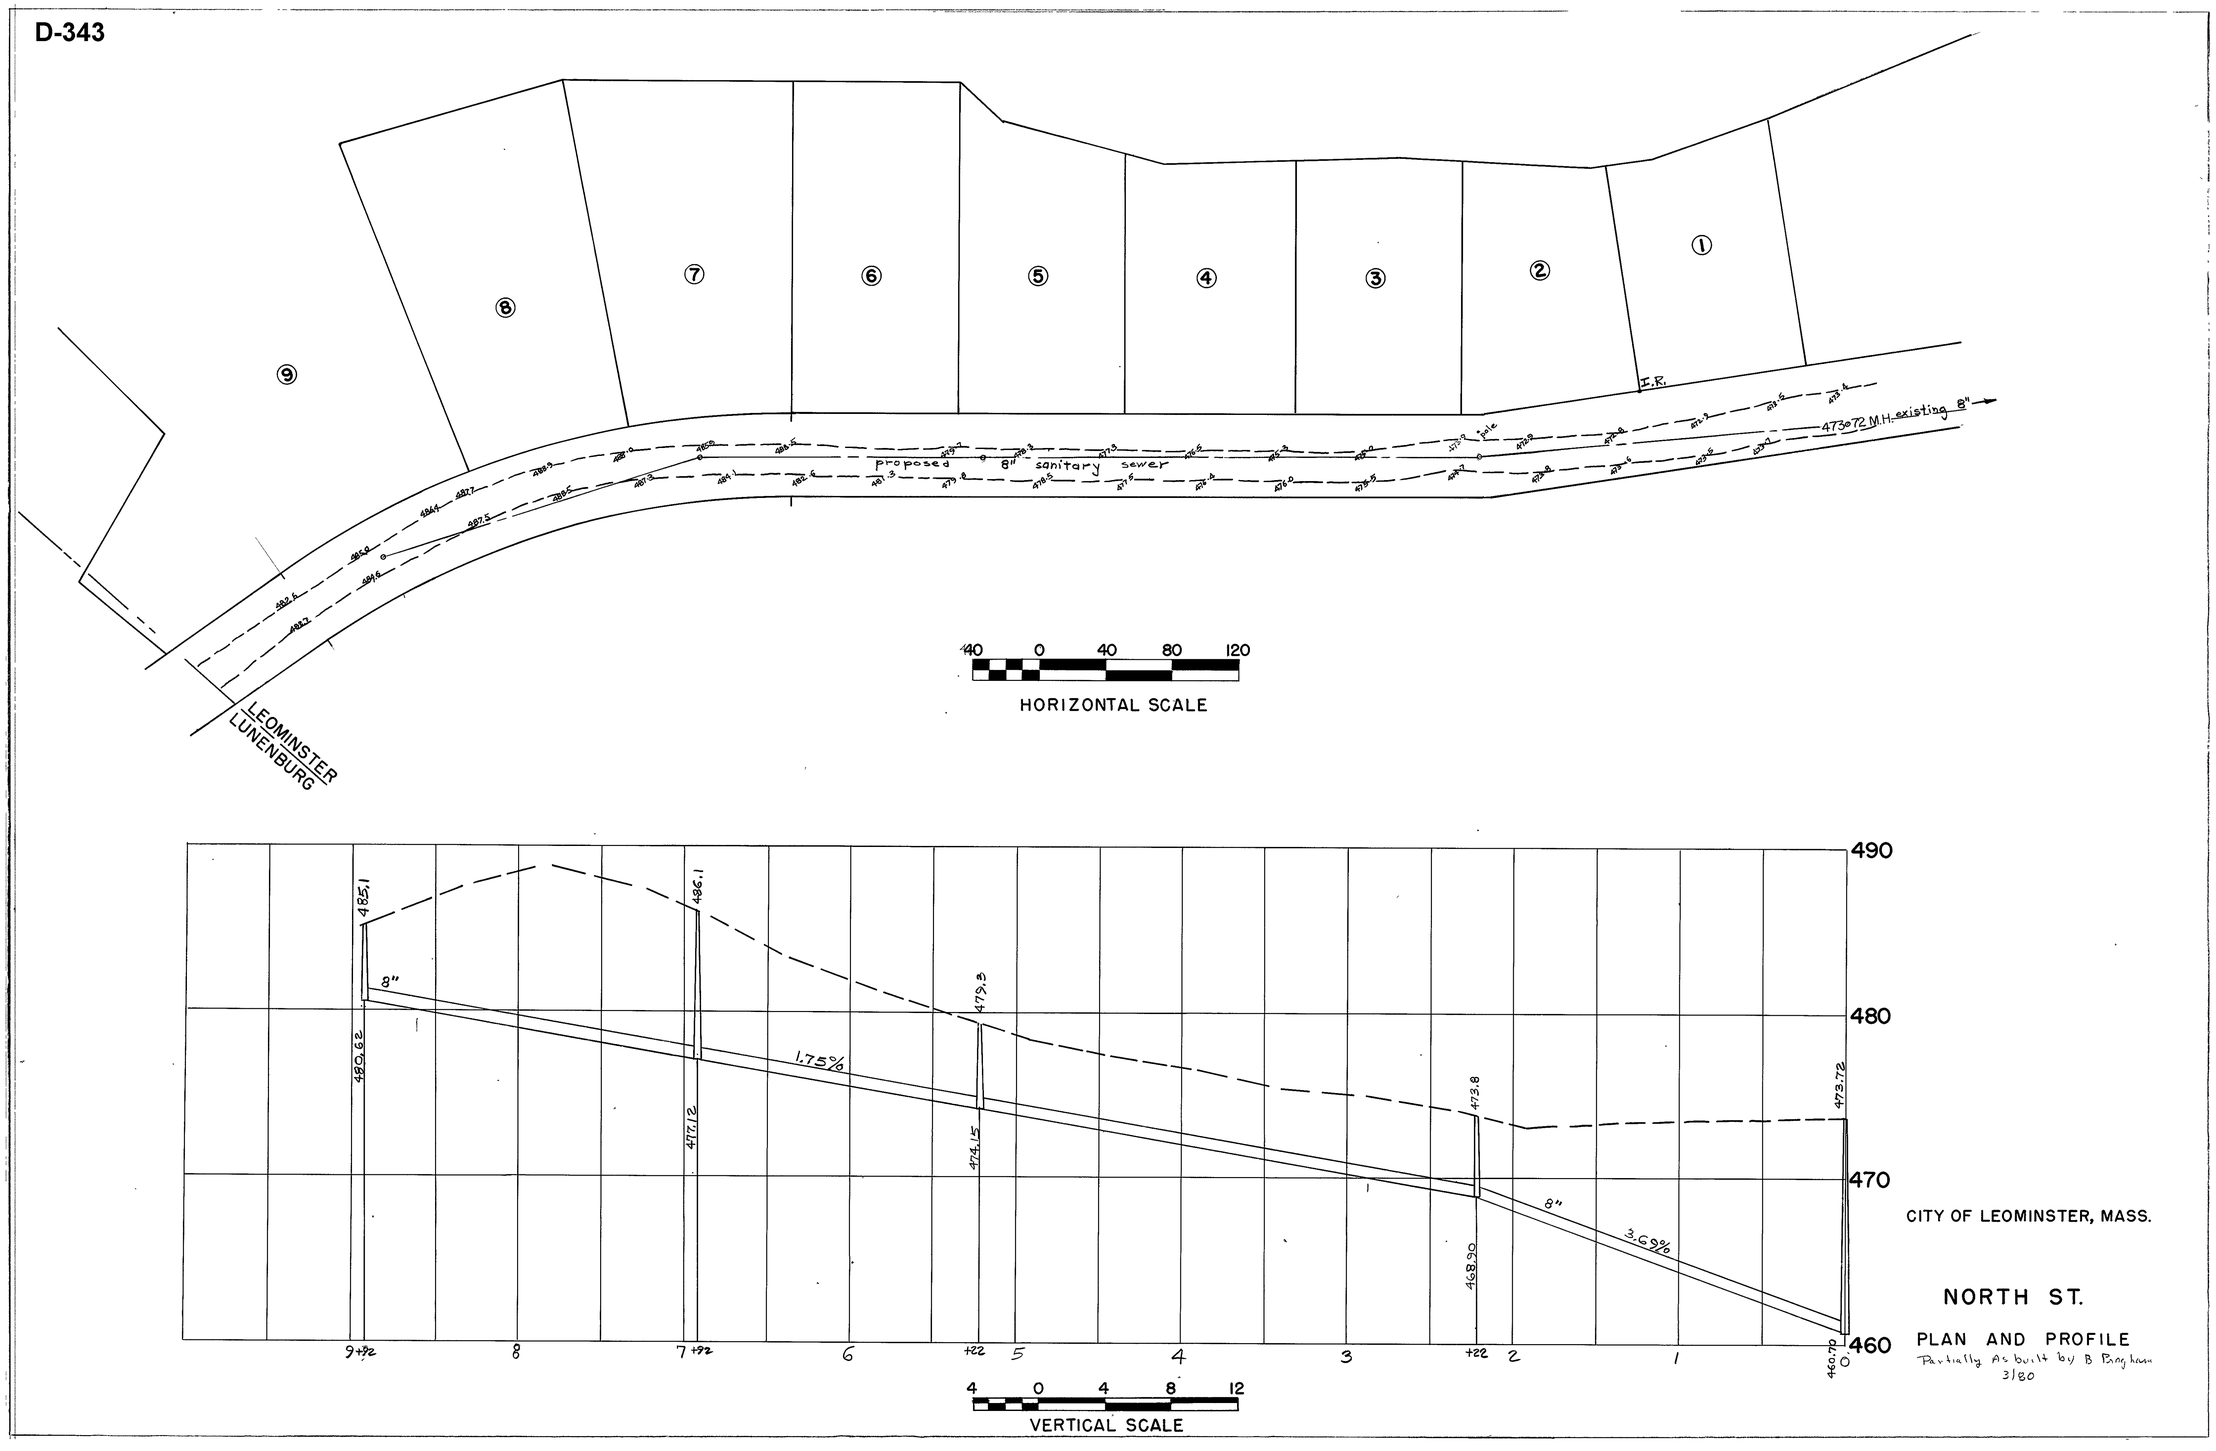

CITY OF LEOMINSTER, MASS.

NORTH ST.

PLAN AND PROFILE

Partially As built by B Bingham 3/80