D-344

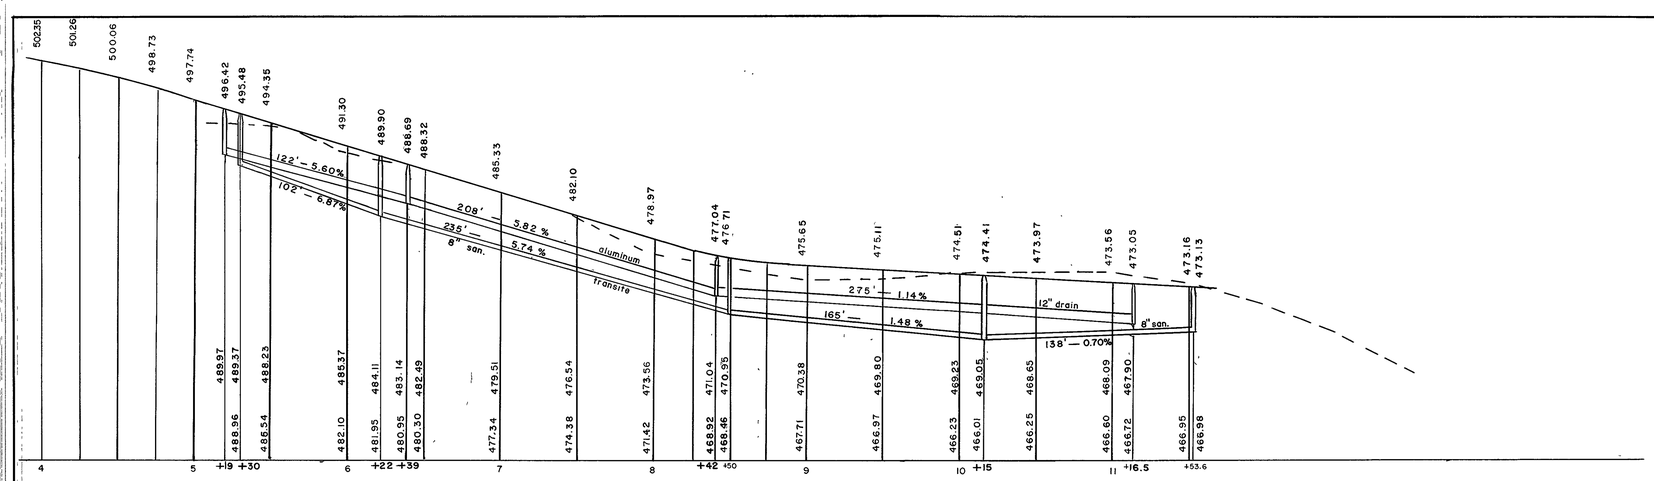

PROFILE

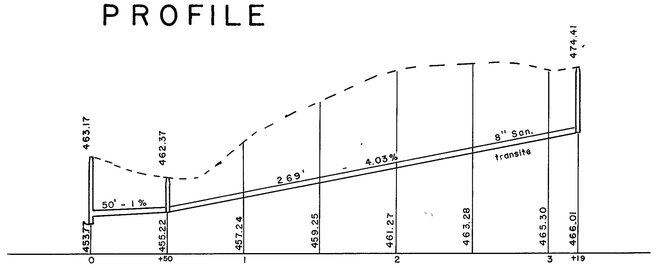

SANITARY SEWER

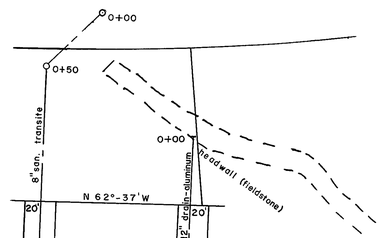

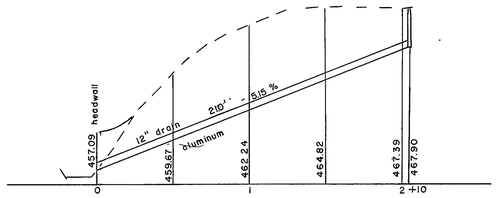

STORM DRAIN

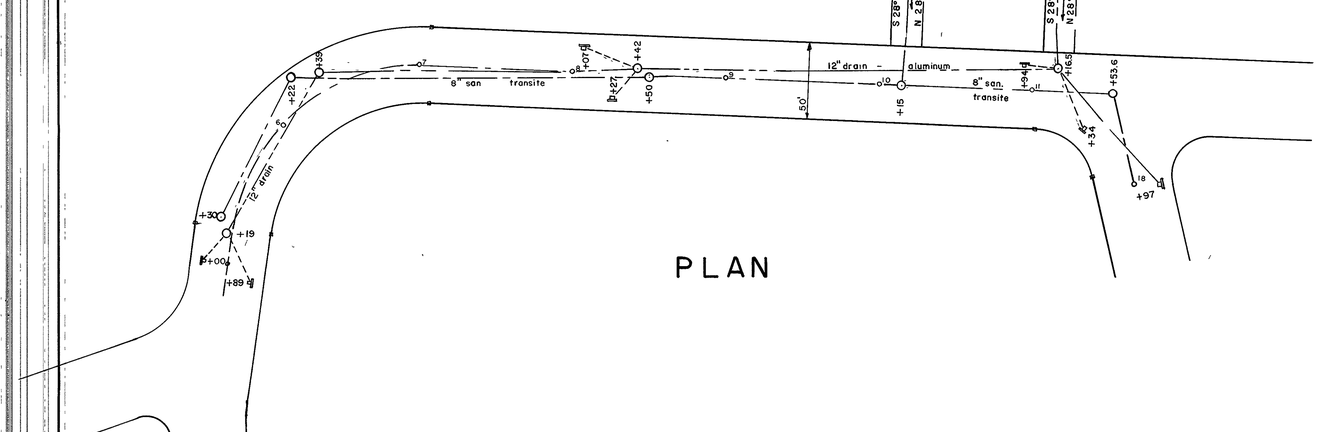

PLAN

SEWER PLAN AND PROFILE
-OF-
GORDON ST.
IN LEOMINSTER, MASS.
SCALE: HOR.-1"= 40' VERT.-1"= 8' - MAY 16, 1974
William R. Bingham & Assoc. - Reg. Engrs & Surveyors
24 Columbia St. - Leominster, Mass.

AS-BUILT DRAWING - JAN 79

D-344