D-345

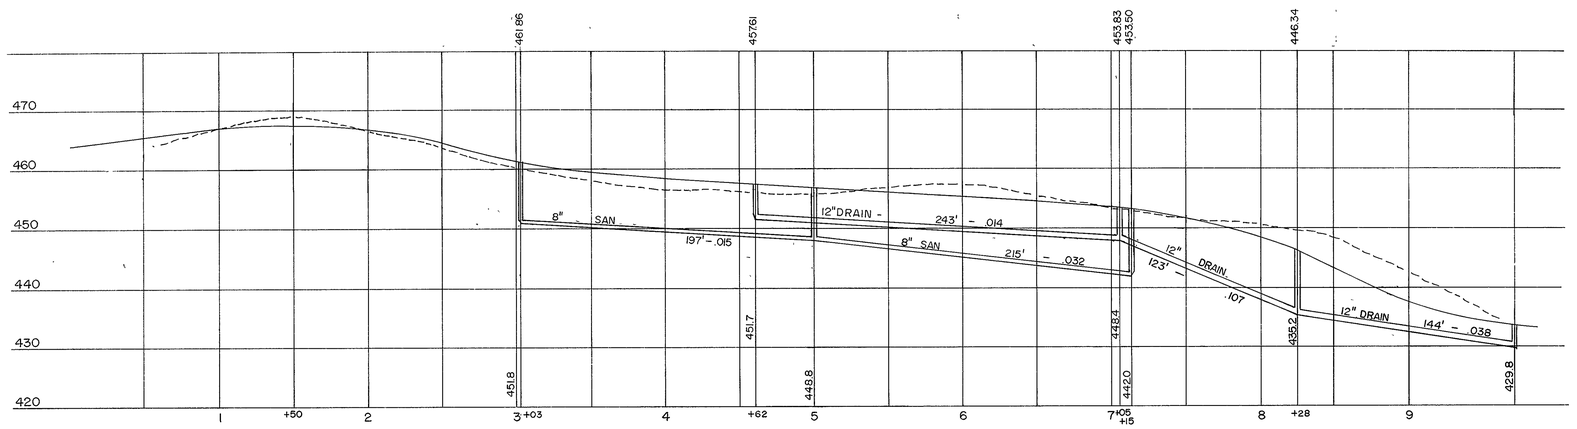

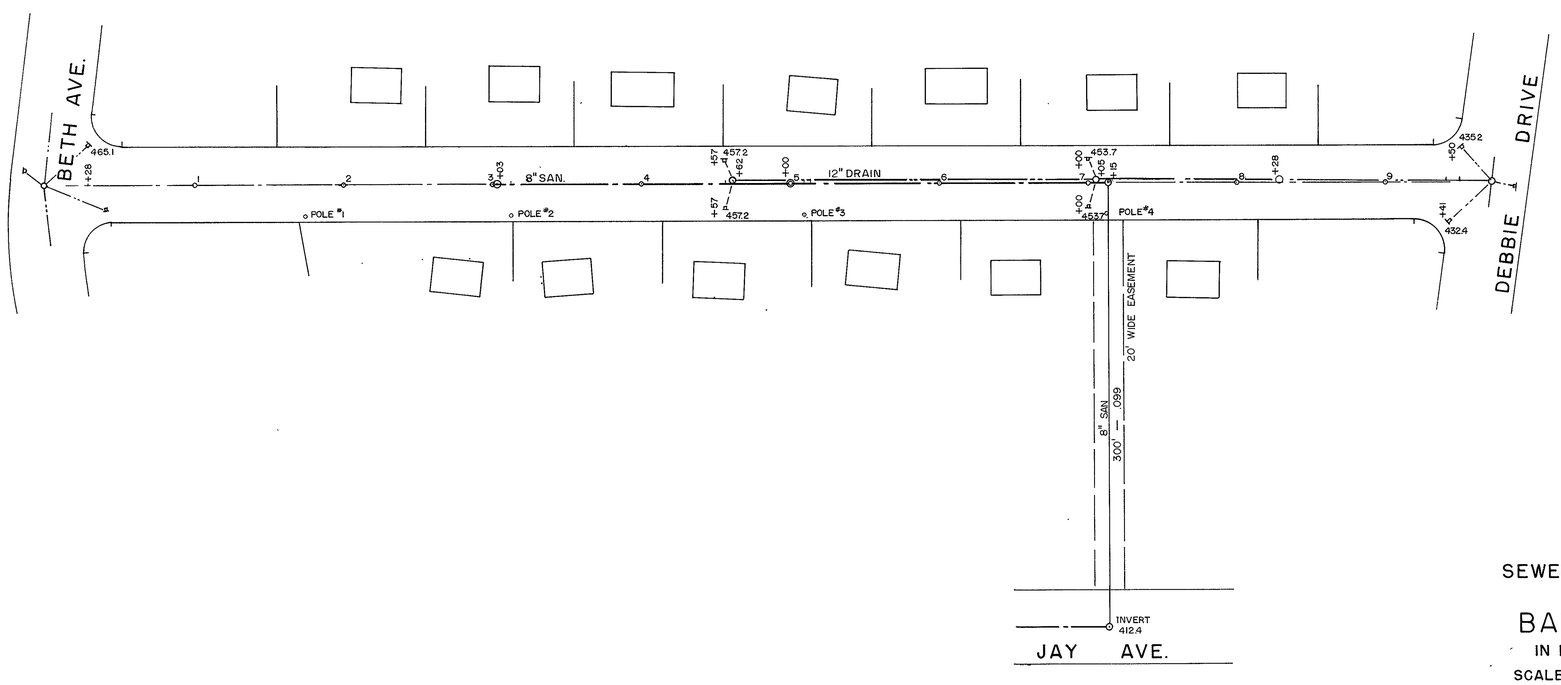

AS-BUILT
SEWER PLAN & PROFILE
OF
BARRY LANE
IN LEOMINSTER, MASS.
SCALE: HOR.-1"=40' VERT.-1"=10' APR. 20, 1981
William R. Bingham & Assoc. - Reg. Engrs. & Surveyors
24 Columbia St. - Leominster, Mass.

AS-BUILT DEC. 83

D-345