D-347

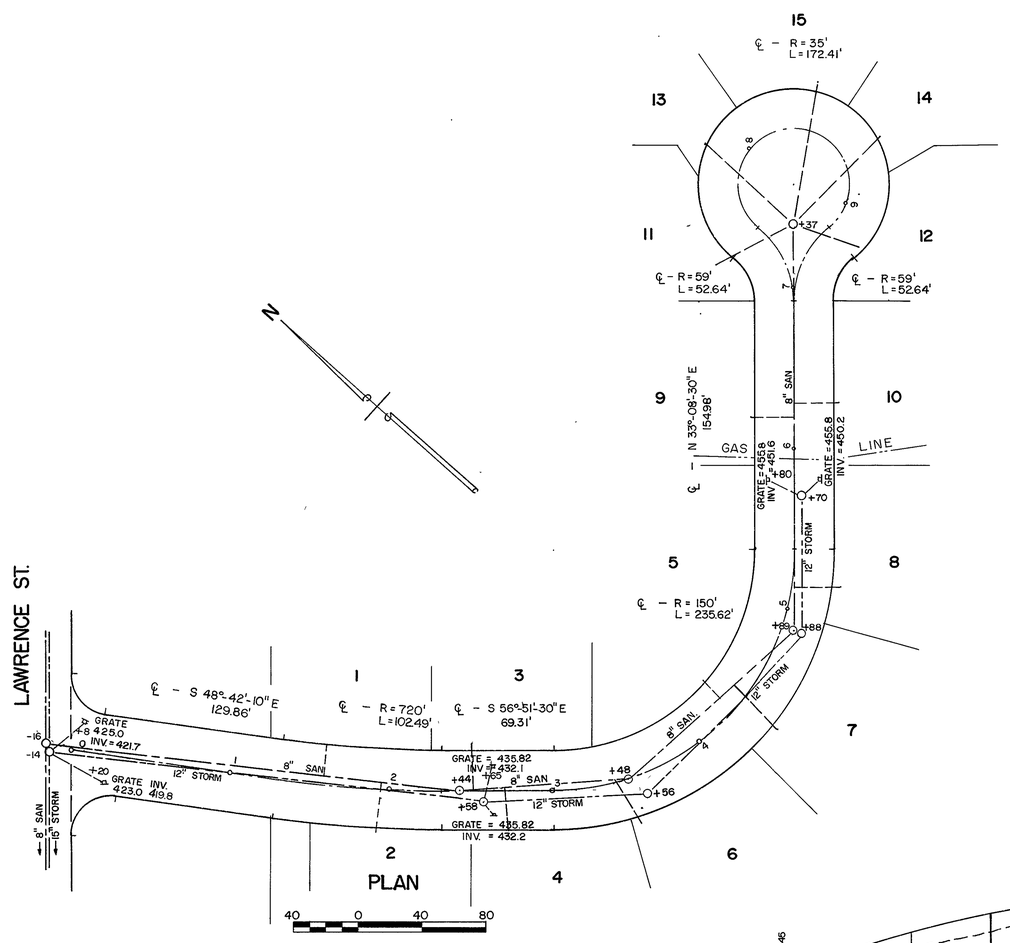

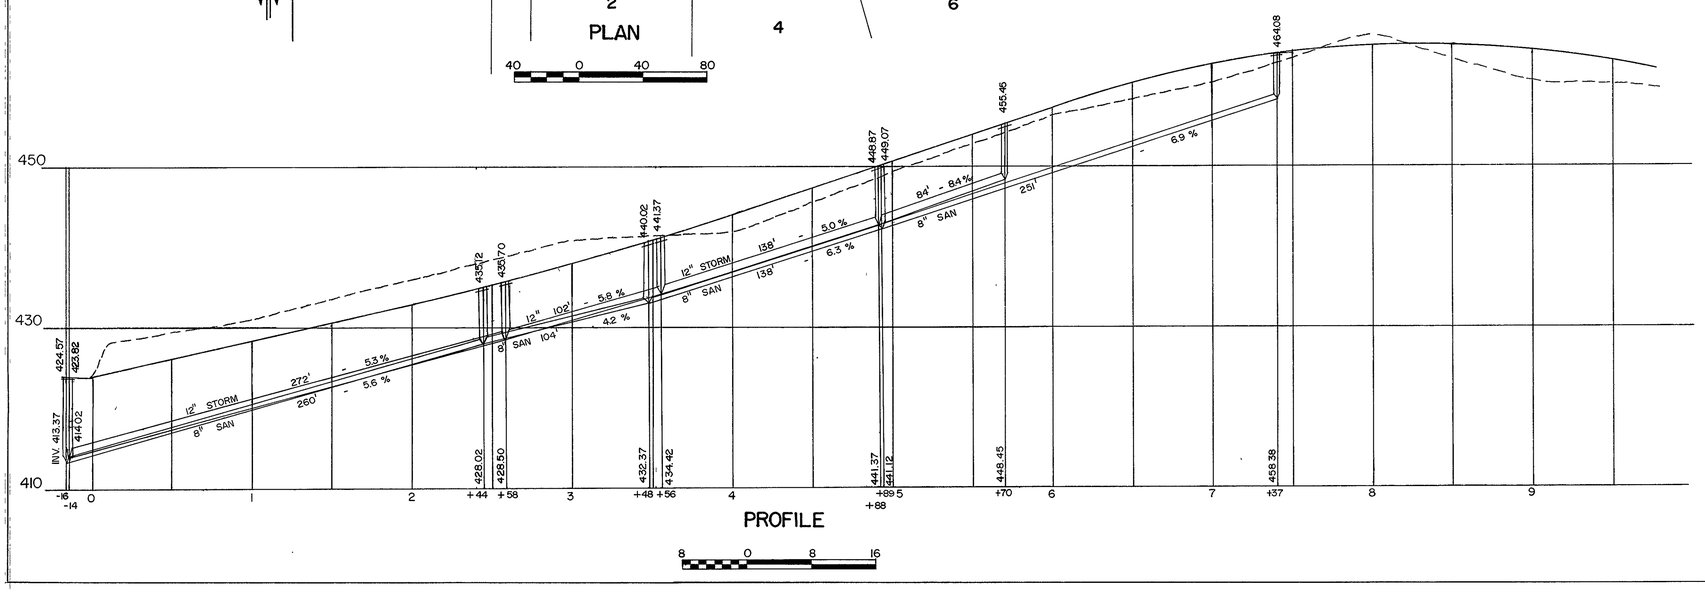

AS-BUILT

SEWER PLAN & PROFILE

OF

ROSEWOOD DRIVE

IN LEOMINSTER, MASS.

SEPTEMBER 19, 1983

SCALES AS SHOWN

WILLIAM R. BINGHAM & ASSOC-REG. ENGRS. & SURVEYORS

24 COLUMBIA ST. - LEOMINSTER, MASS.