D-356a

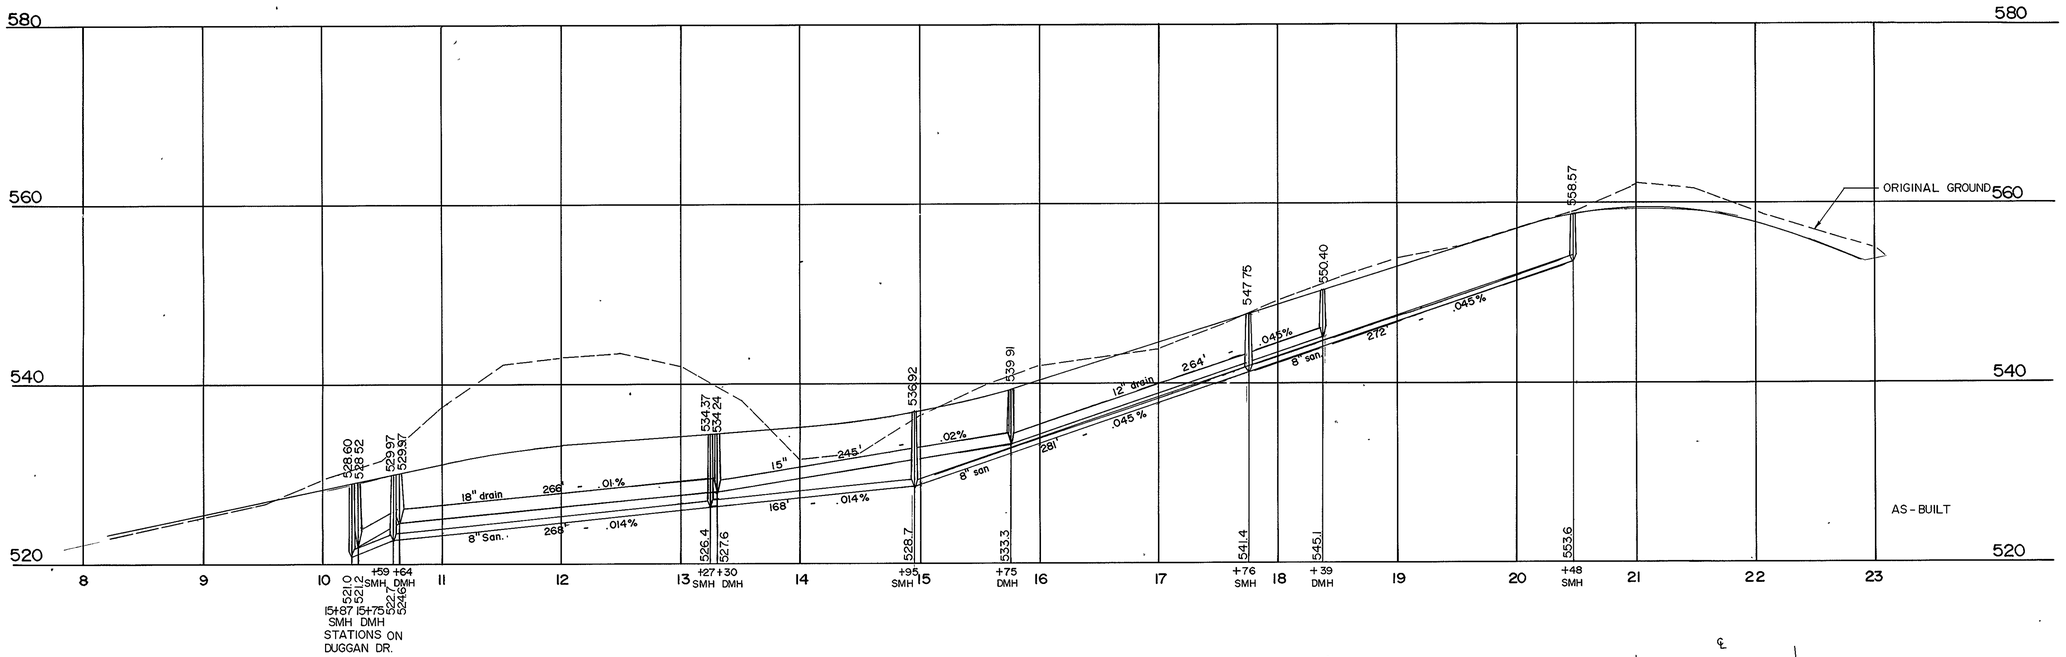

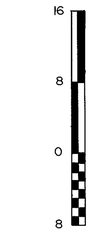

PROFILE

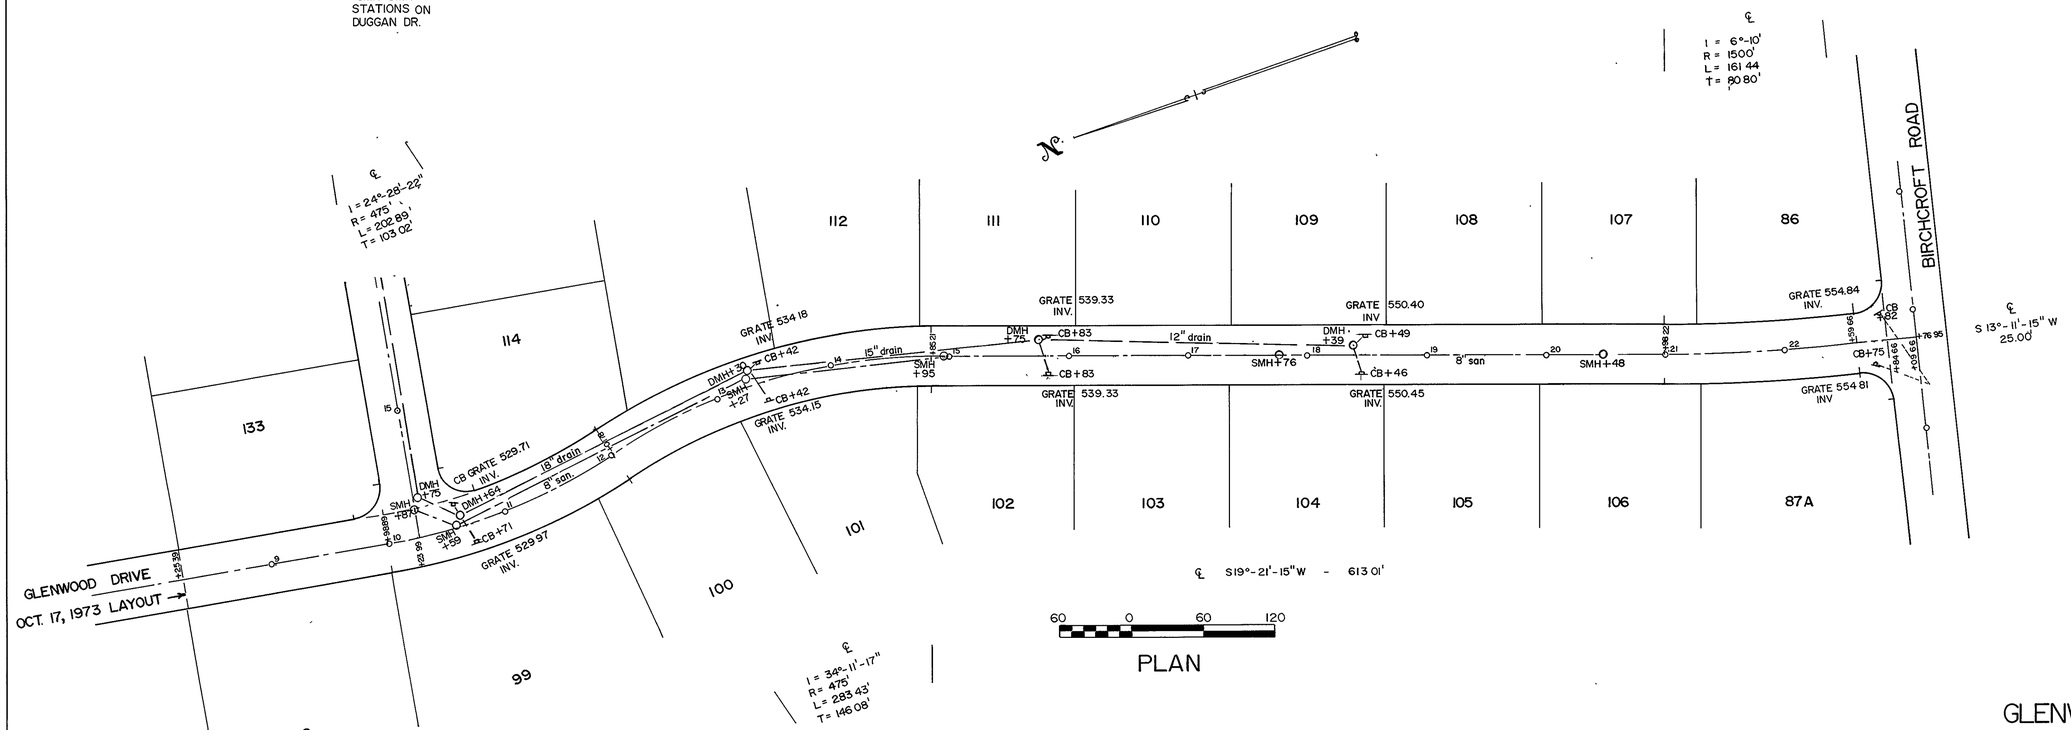

PLAN

AS-BUILT

SEWER PLAN

OF

GLENWOOD DRIVE EXTENSION

IN LEOMINSTER, MASS.

DECEMBER 2, 1987

SCALES AS SHOWN

WILLIAM R. BINGHAM & ASSOC.-REG. ENGRS. & SURVEYORS

24 COLUMBIA ST — LEOMINSTER, MASS.

D-356 B