D-358

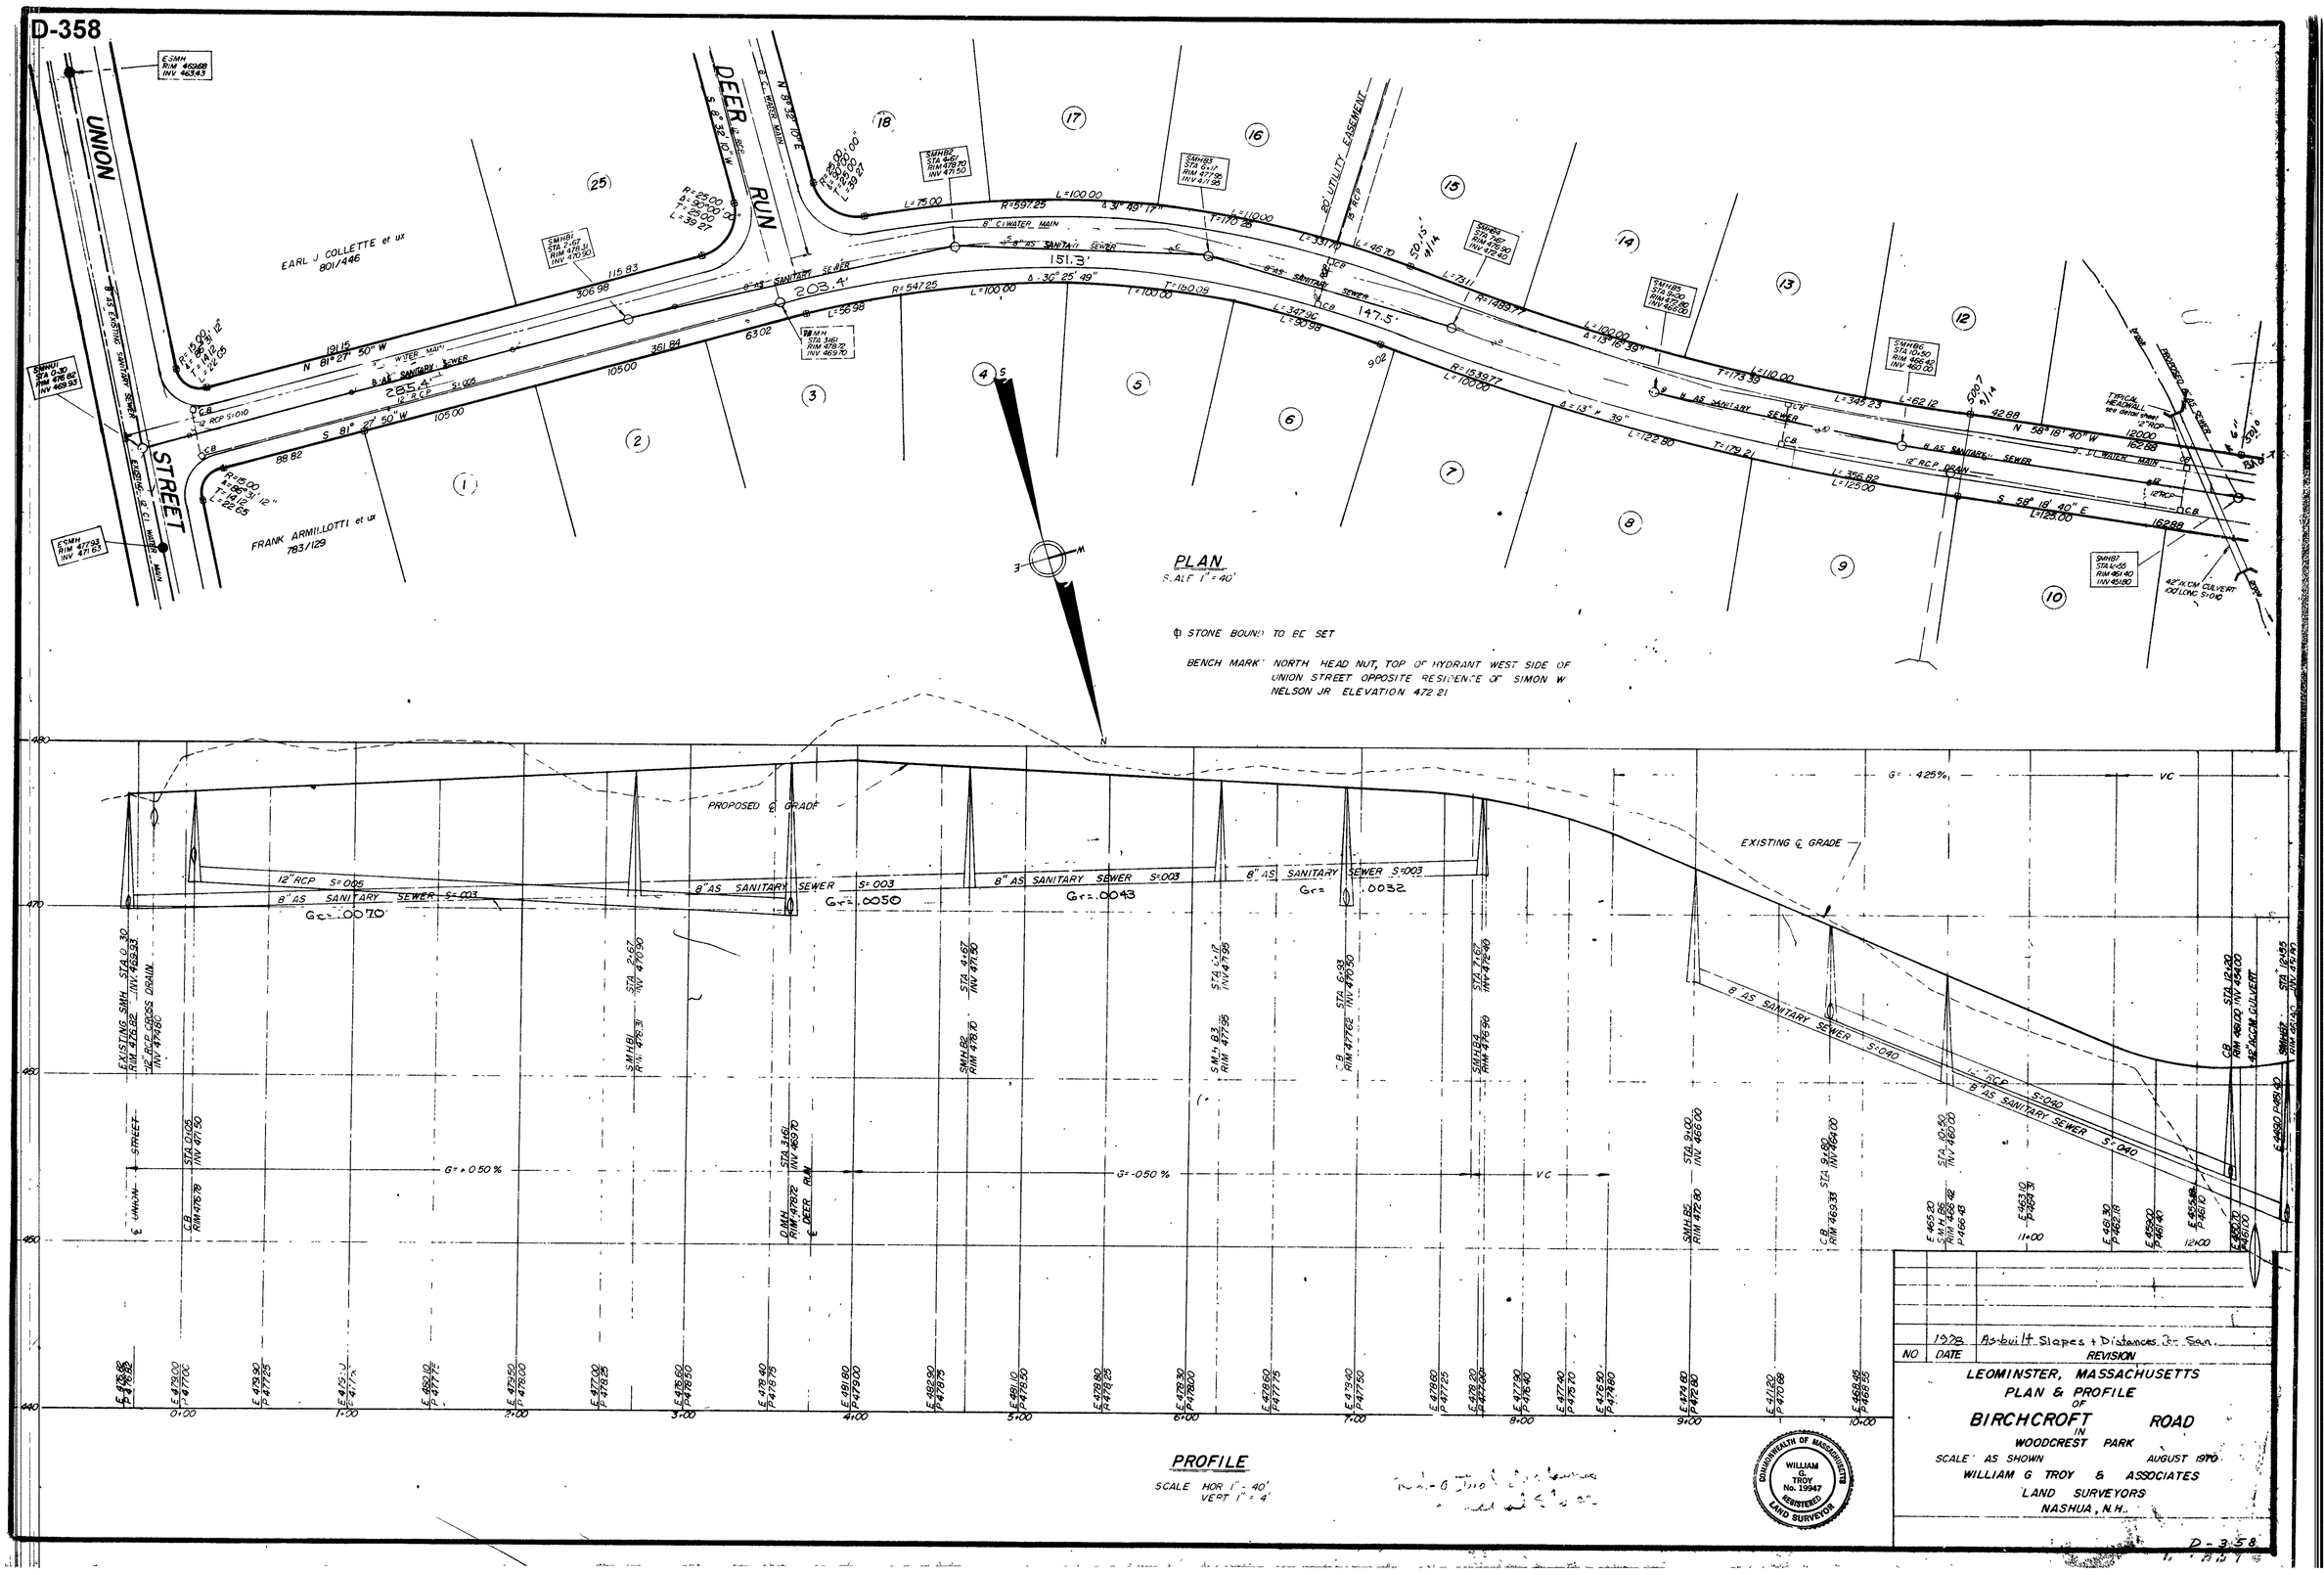

NO	DATE	REVISION
	1978	As-built Slopes + Distances Sr. San.

LEOMINSTER, MASSACHUSETTS
PLAN & PROFILE
OF
BIRCHCROFT ROAD
IN
WOODCREST PARK

SCALE: AS SHOWN AUGUST 1970

WILLIAM G TROY & ASSOCIATES
LAND SURVEYORS
NASHUA, N.H.

COMMONWEALTH OF MASSACHUSETTS
WILLIAM G. TROY
No. 19947
REGISTERED
LAND SURVEYOR

D-358