D-362

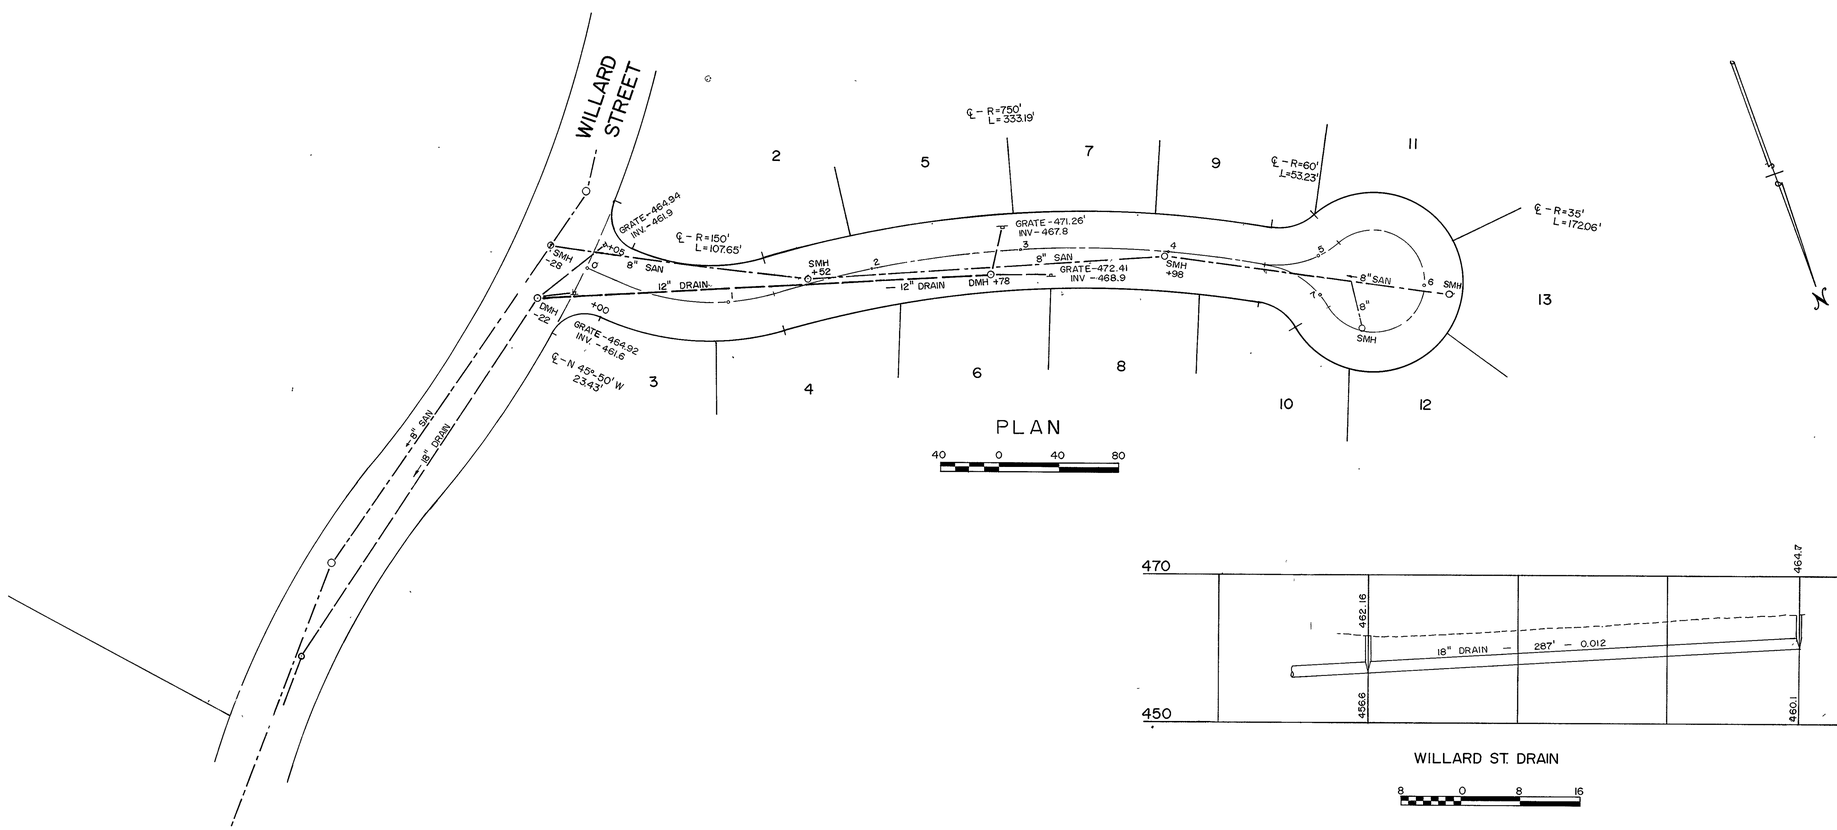

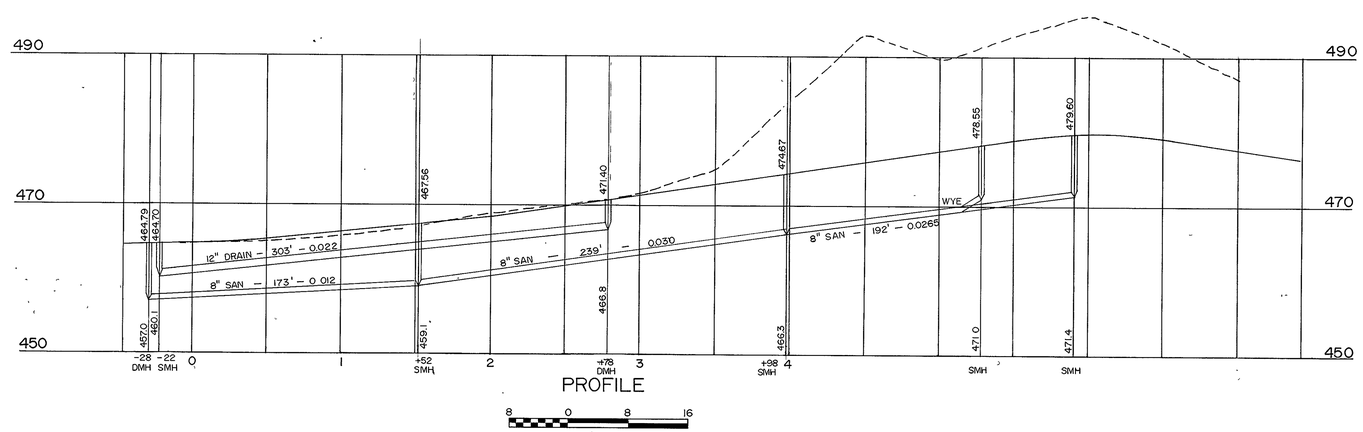

AS-BUILT

SEWER PLAN & PROFILE

OF

WEDGEWOOD LANE

IN LEOMINSTER, MASS.

MARCH 12, 1986

SCALES AS SHOWN

WILLIAM R. BINGHAM & ASSOC.-REG. ENGRS. & SURVEYORS

24 COLUMBIA ST. - LEOMINSTER, MASS.

D-362