D-363

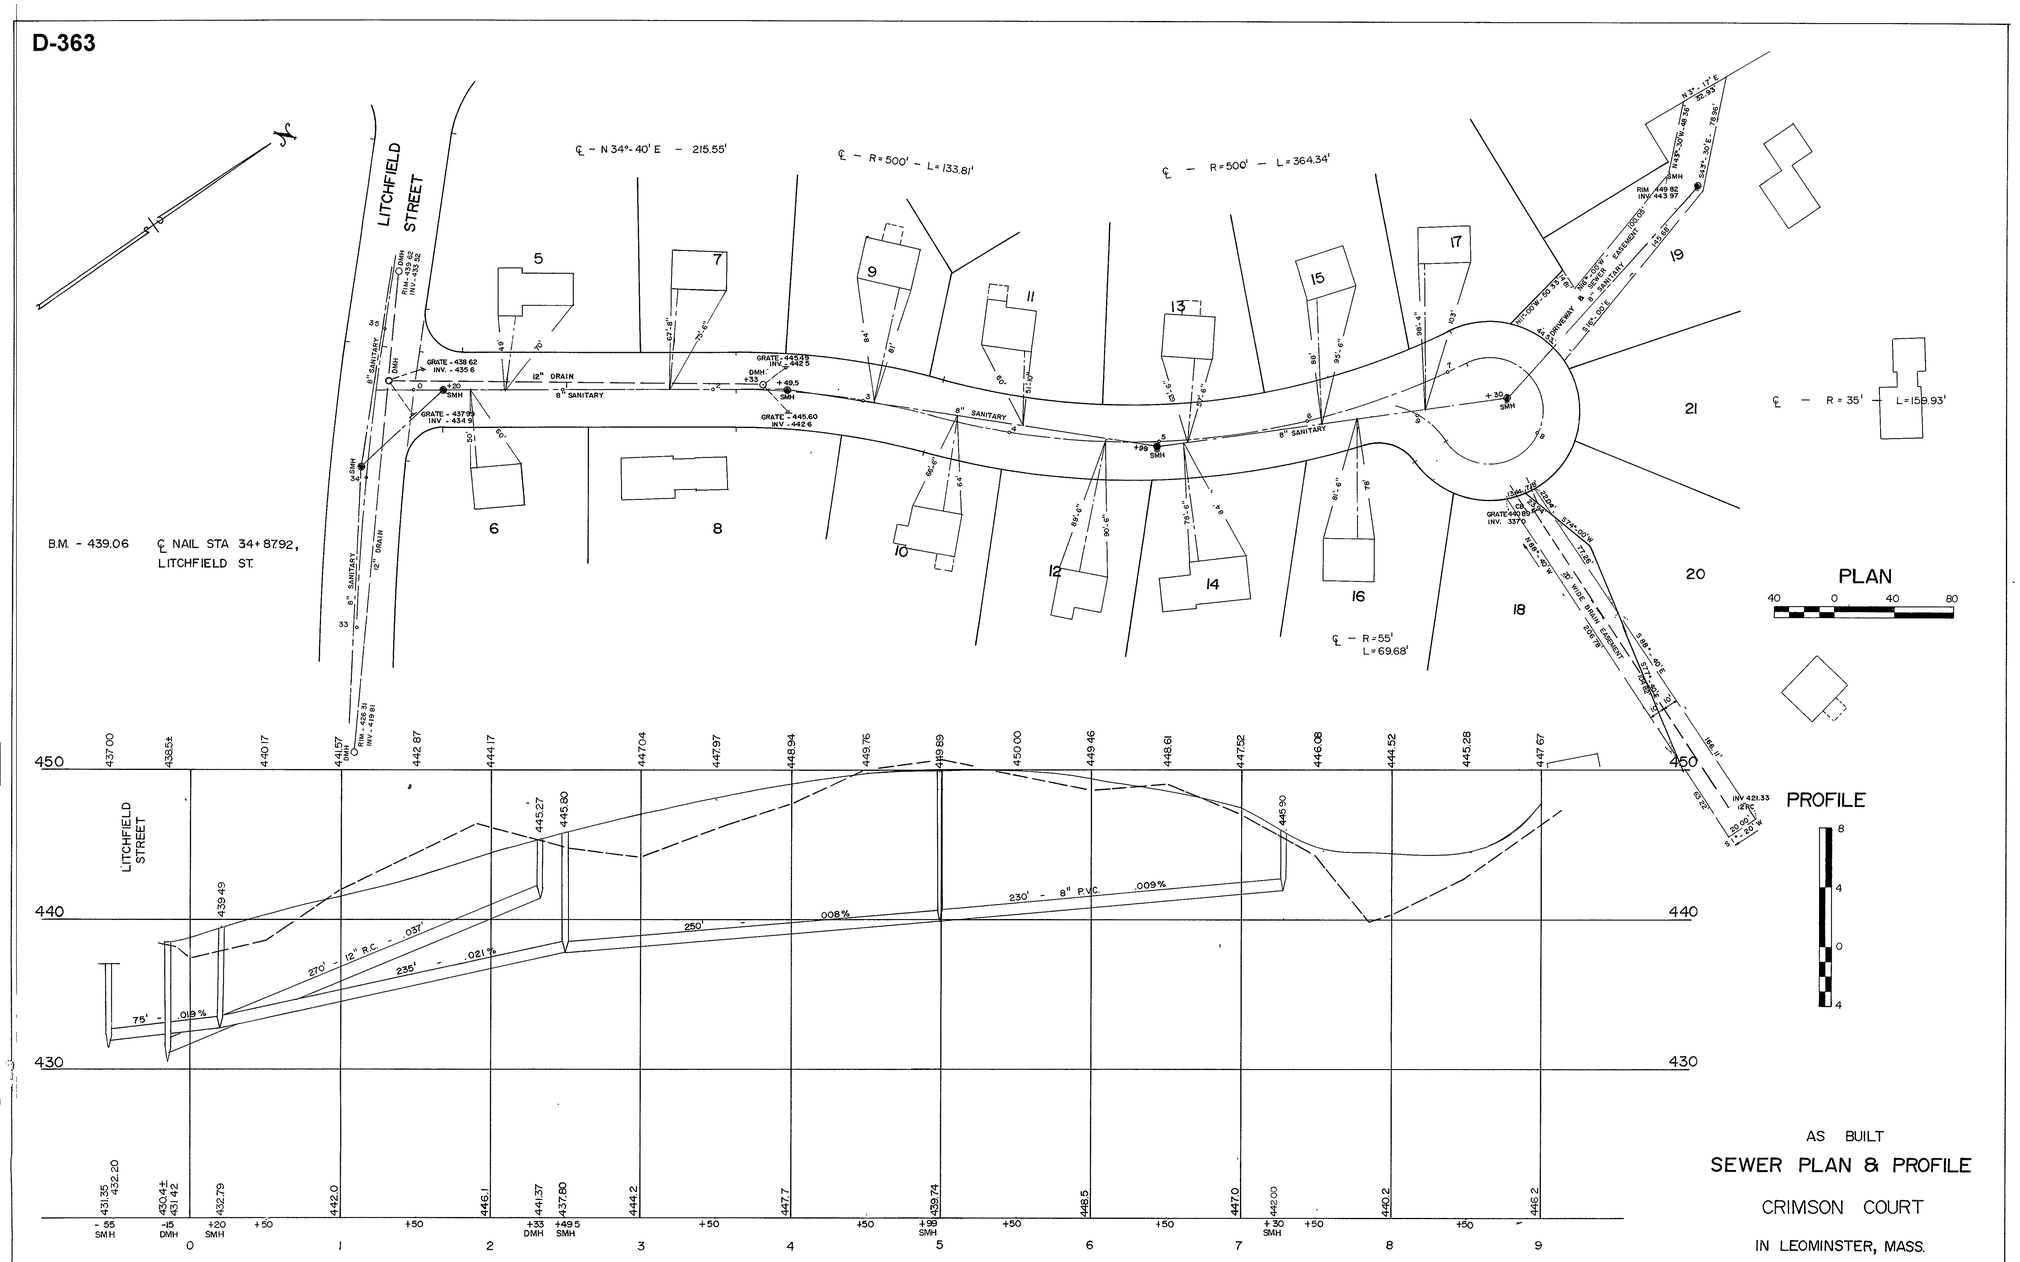
LITCHFIELD STREET
℄ – N 34°-40' E – 215.55'
℄ – R = 500' – L = 133.81'
℄ – R = 500' – L = 364.34'
℄ – R = 35' – L = 159.93'
℄ – R = 55' L = 69.68'
B.M. - 439.06 ℄ NAIL STA 34+87.92, LITCHFIELD ST.
PLAN
PROFILE
AS BUILT
SEWER PLAN & PROFILE
CRIMSON COURT
IN LEOMINSTER, MASS.
JULY 11, 1986
SCALES AS SHOWN
WILLIAM R. BINGHAM & ASSOC.– REG. ENGRS. & SURVEYORS
24 COLUMBIA ST. — LEOMINSTER, MASS.