D-364

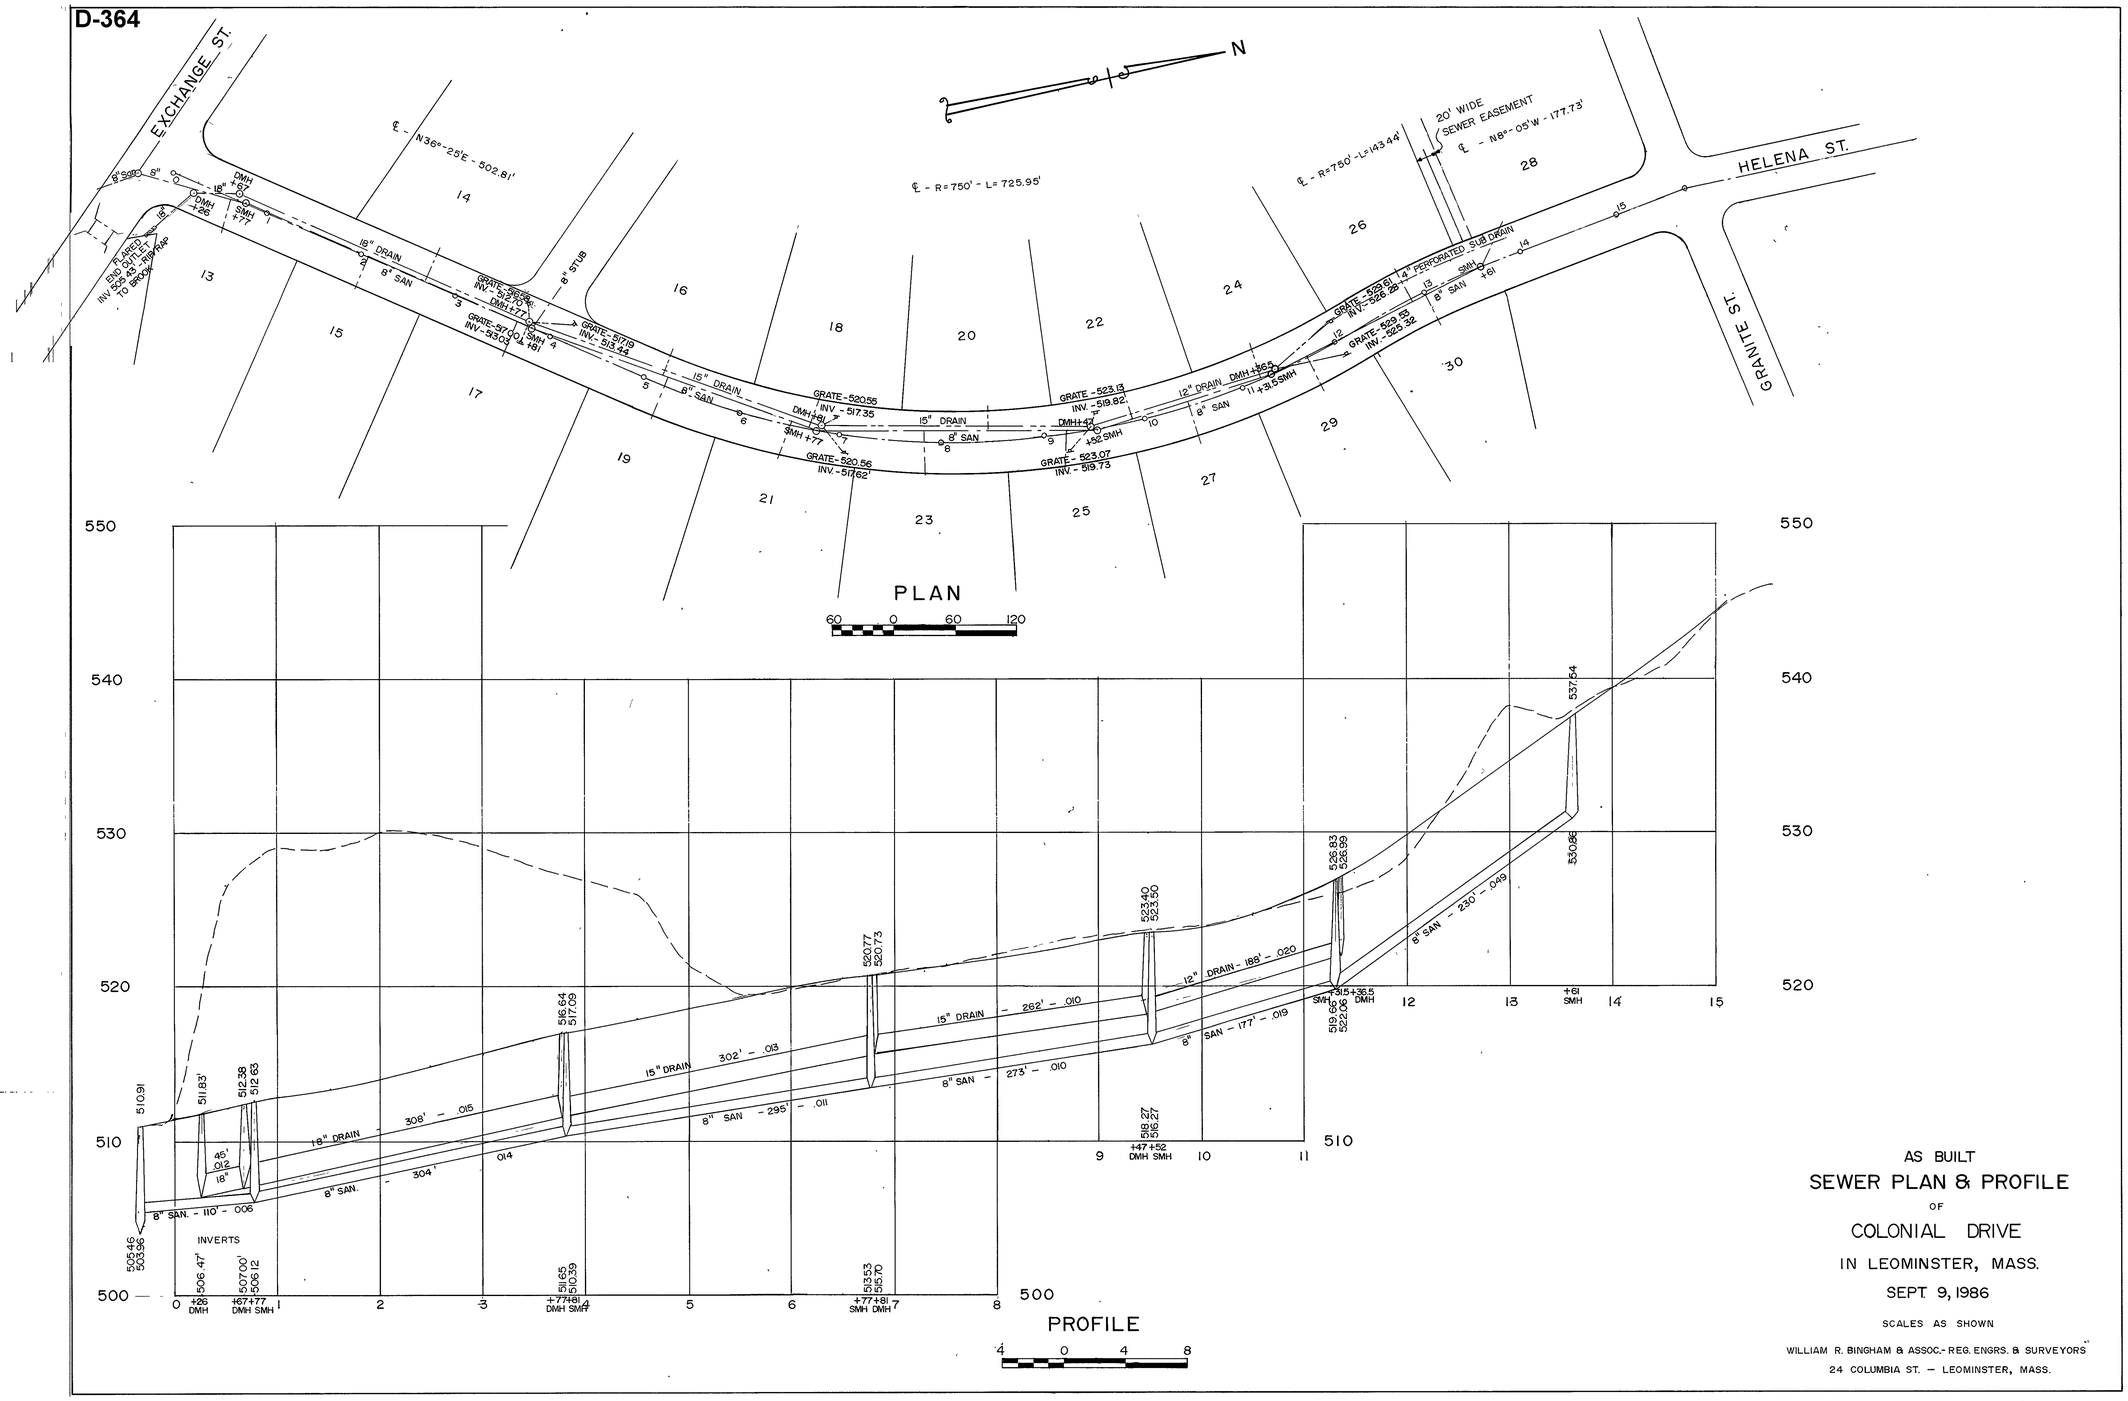

AS BUILT

SEWER PLAN & PROFILE

OF

COLONIAL DRIVE

IN LEOMINSTER, MASS.

SEPT. 9, 1986

SCALES AS SHOWN

WILLIAM R. BINGHAM & ASSOC.- REG. ENGRS. & SURVEYORS

24 COLUMBIA ST. — LEOMINSTER, MASS.