D-367

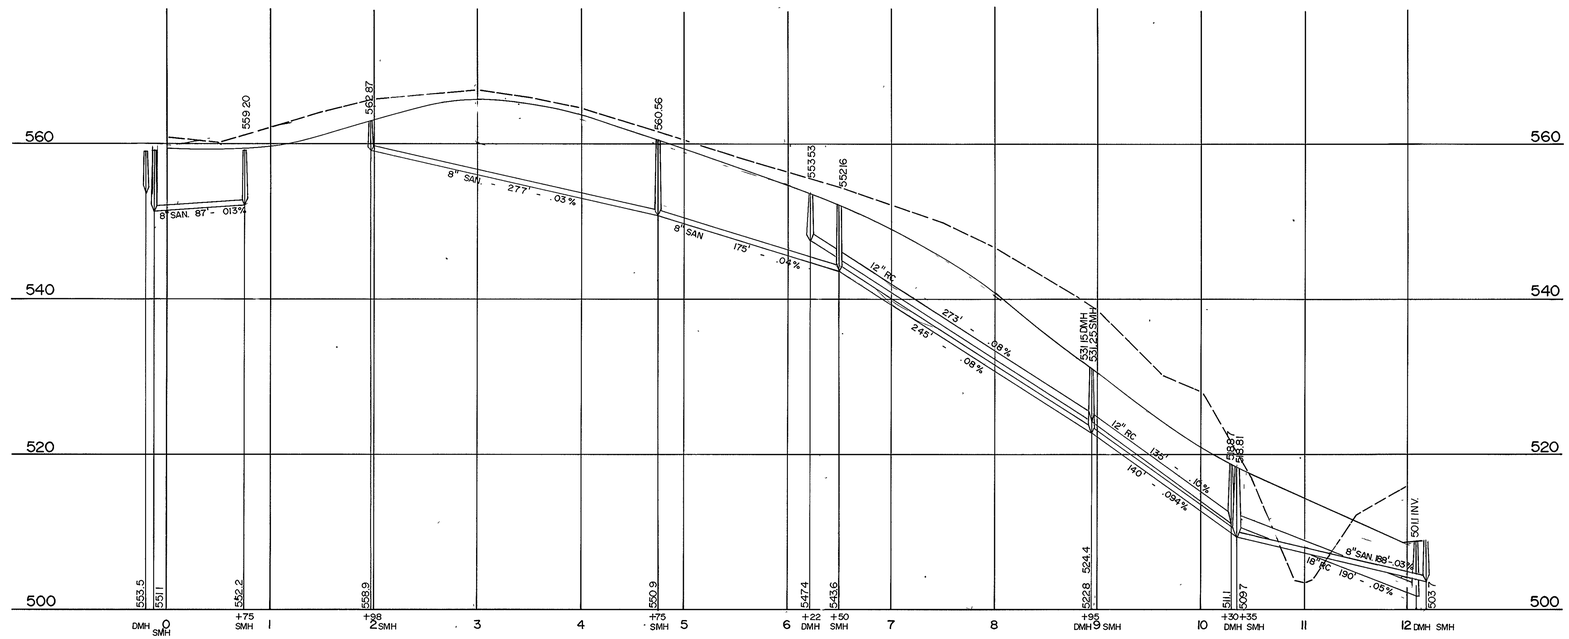

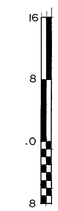

PROFILE

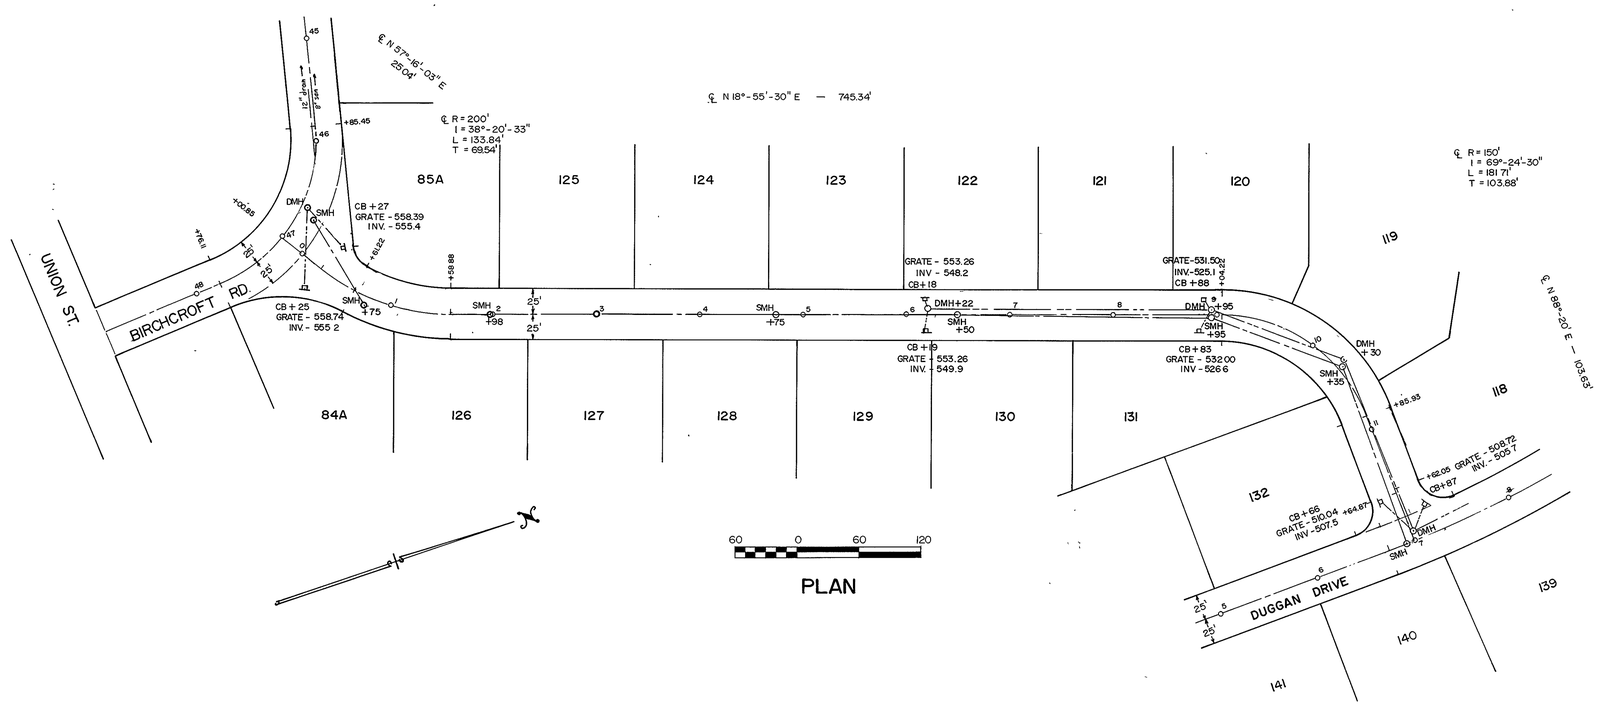

PLAN

AS BUILT

SANITARY & STORM DRAIN

OF

COMSTOCK ROAD

IN LEOMINSTER, MASS.

DECEMBER 15, 1987

SCALES AS SHOWN

WILLIAM R. BINGHAM & ASSOC.-REG. ENGRS. & SURVEYORS

24 COLUMBIA ST. - LEOMINSTER, MASS.