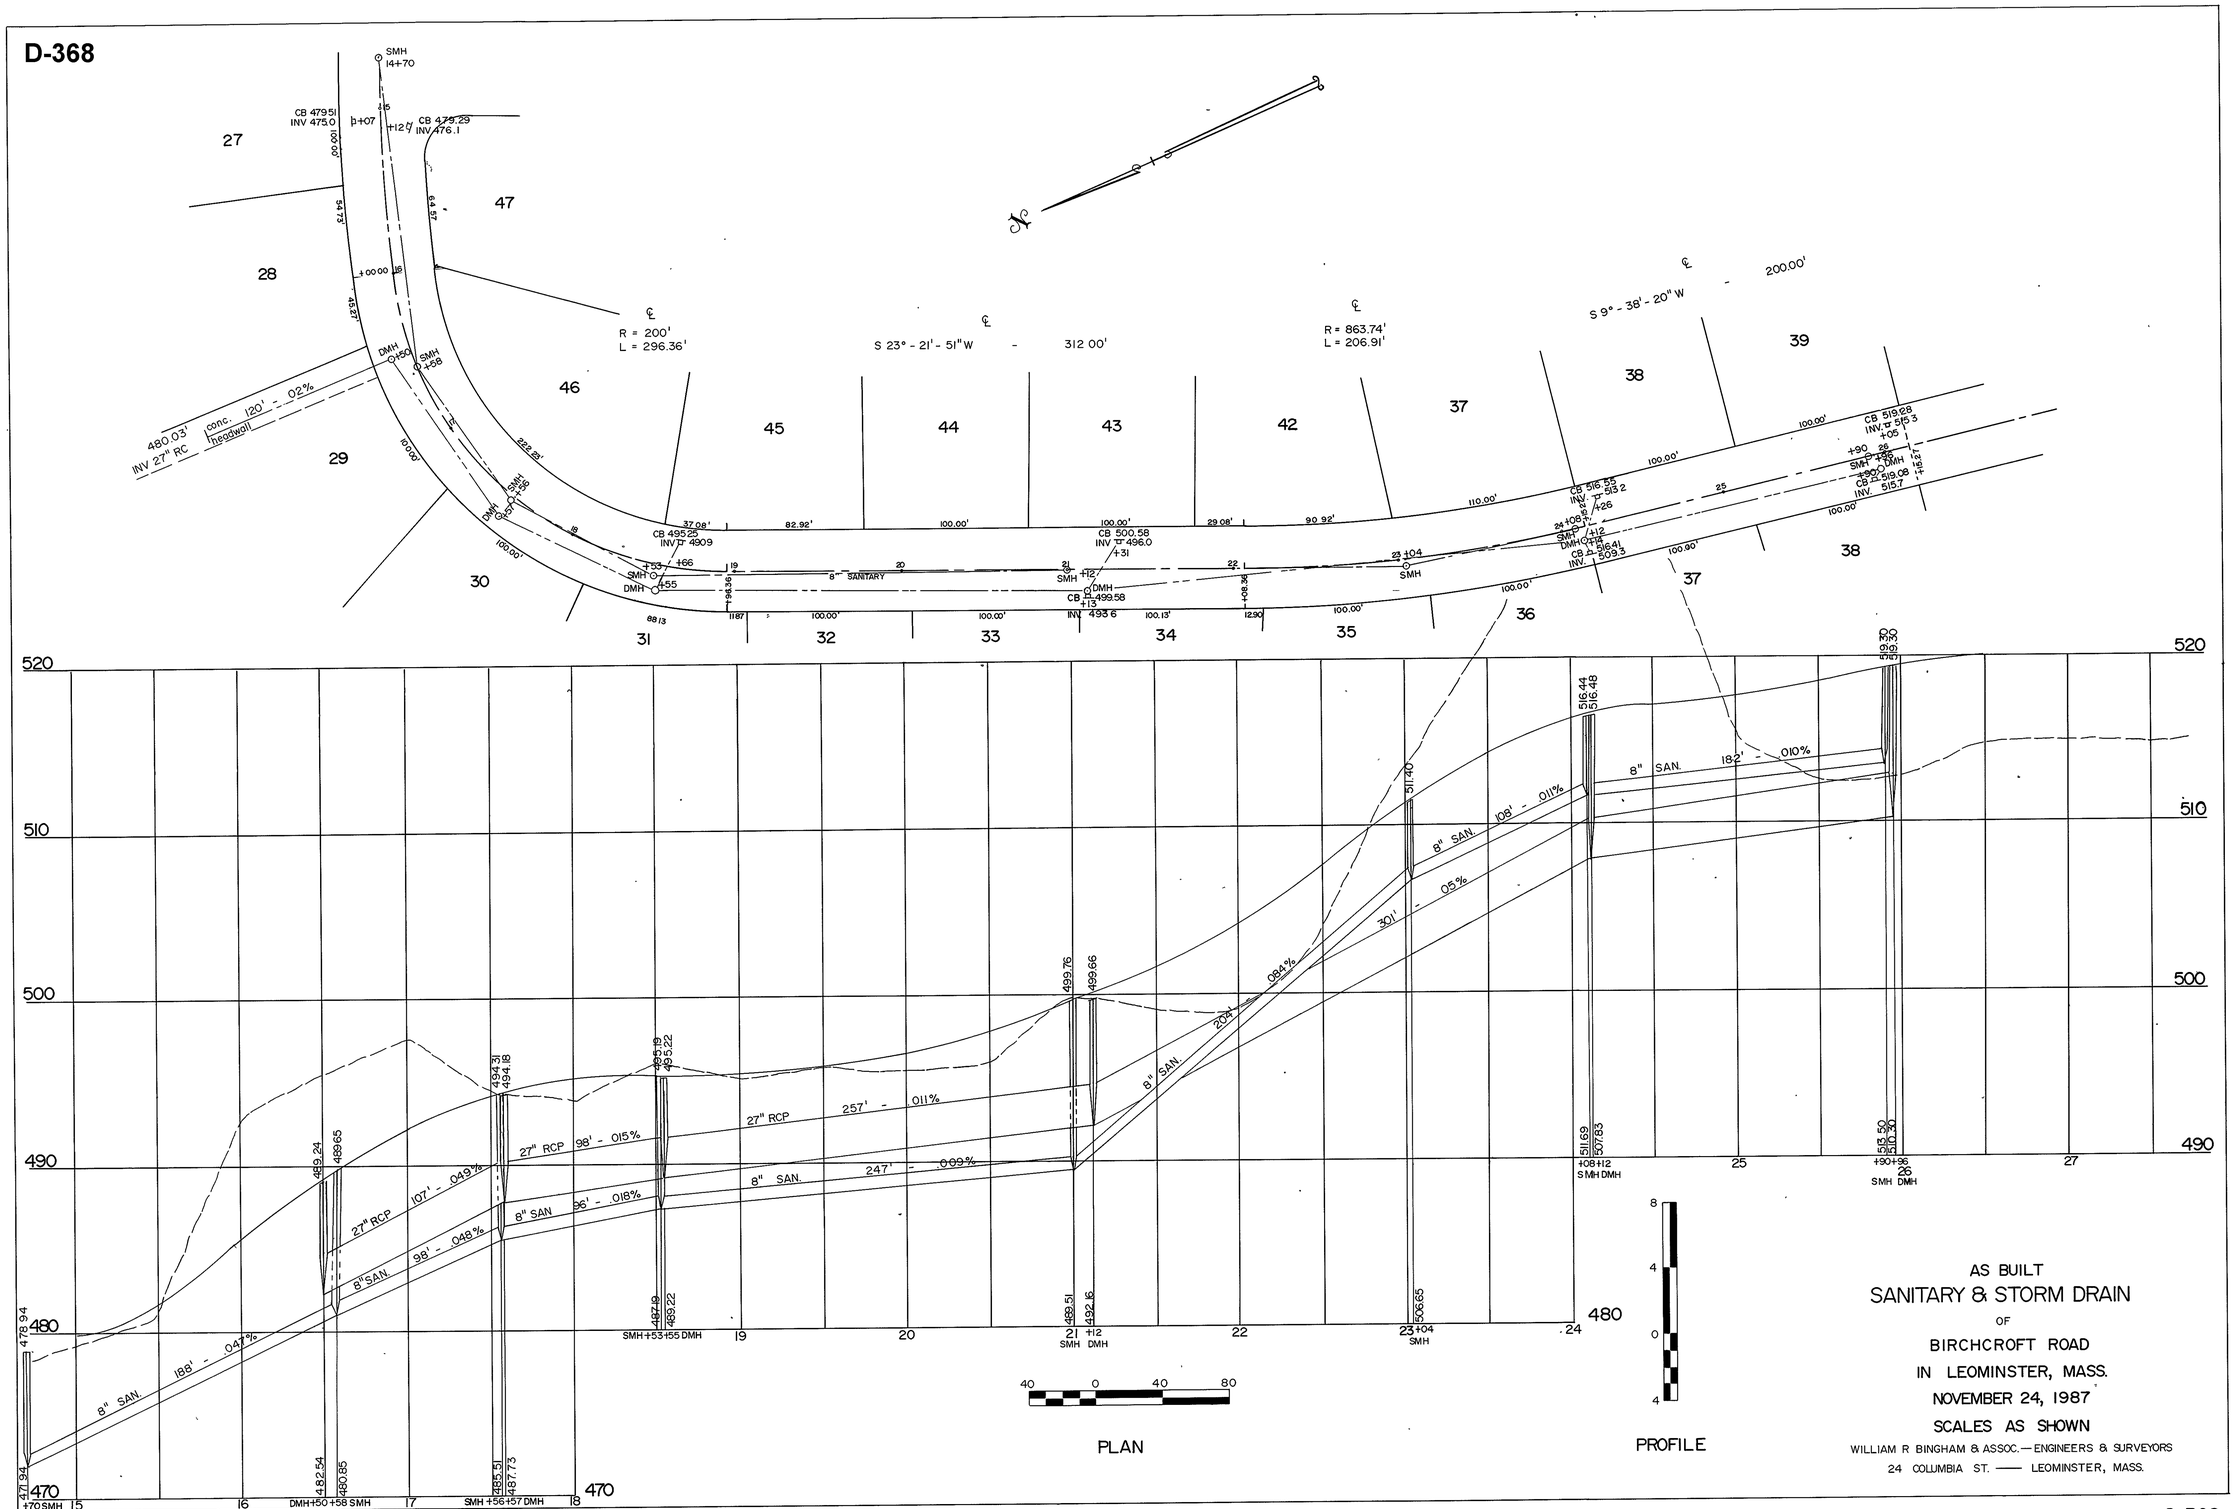
D-368
R = 200'
L = 296.36'
S 23° - 21' - 51" W - 312.00'
R = 863.74'
L = 206.91'
S 9° - 38' - 20" W - 200.00'
480.03'
INV 27" RC
conc. headwall
120' - .02%
8" SANITARY
8" SAN. 188' - .047%
27" RCP 107' - .049%
8" SAN. 98' - .048%
27" RCP 98' - .015%
8" SAN. 96' - .018%
27" RCP 257' - .011%
8" SAN. 247' - .009%
8" SAN. 204' - .084%
8" SAN. 108' - .011%
8" SAN. 182' - .010%
301' - .05%
PLAN
PROFILE
AS BUILT
SANITARY & STORM DRAIN
OF
BIRCHCROFT ROAD
IN LEOMINSTER, MASS.
NOVEMBER 24, 1987
SCALES AS SHOWN
WILLIAM R BINGHAM & ASSOC.—ENGINEERS & SURVEYORS
24 COLUMBIA ST. —— LEOMINSTER, MASS.