D-369

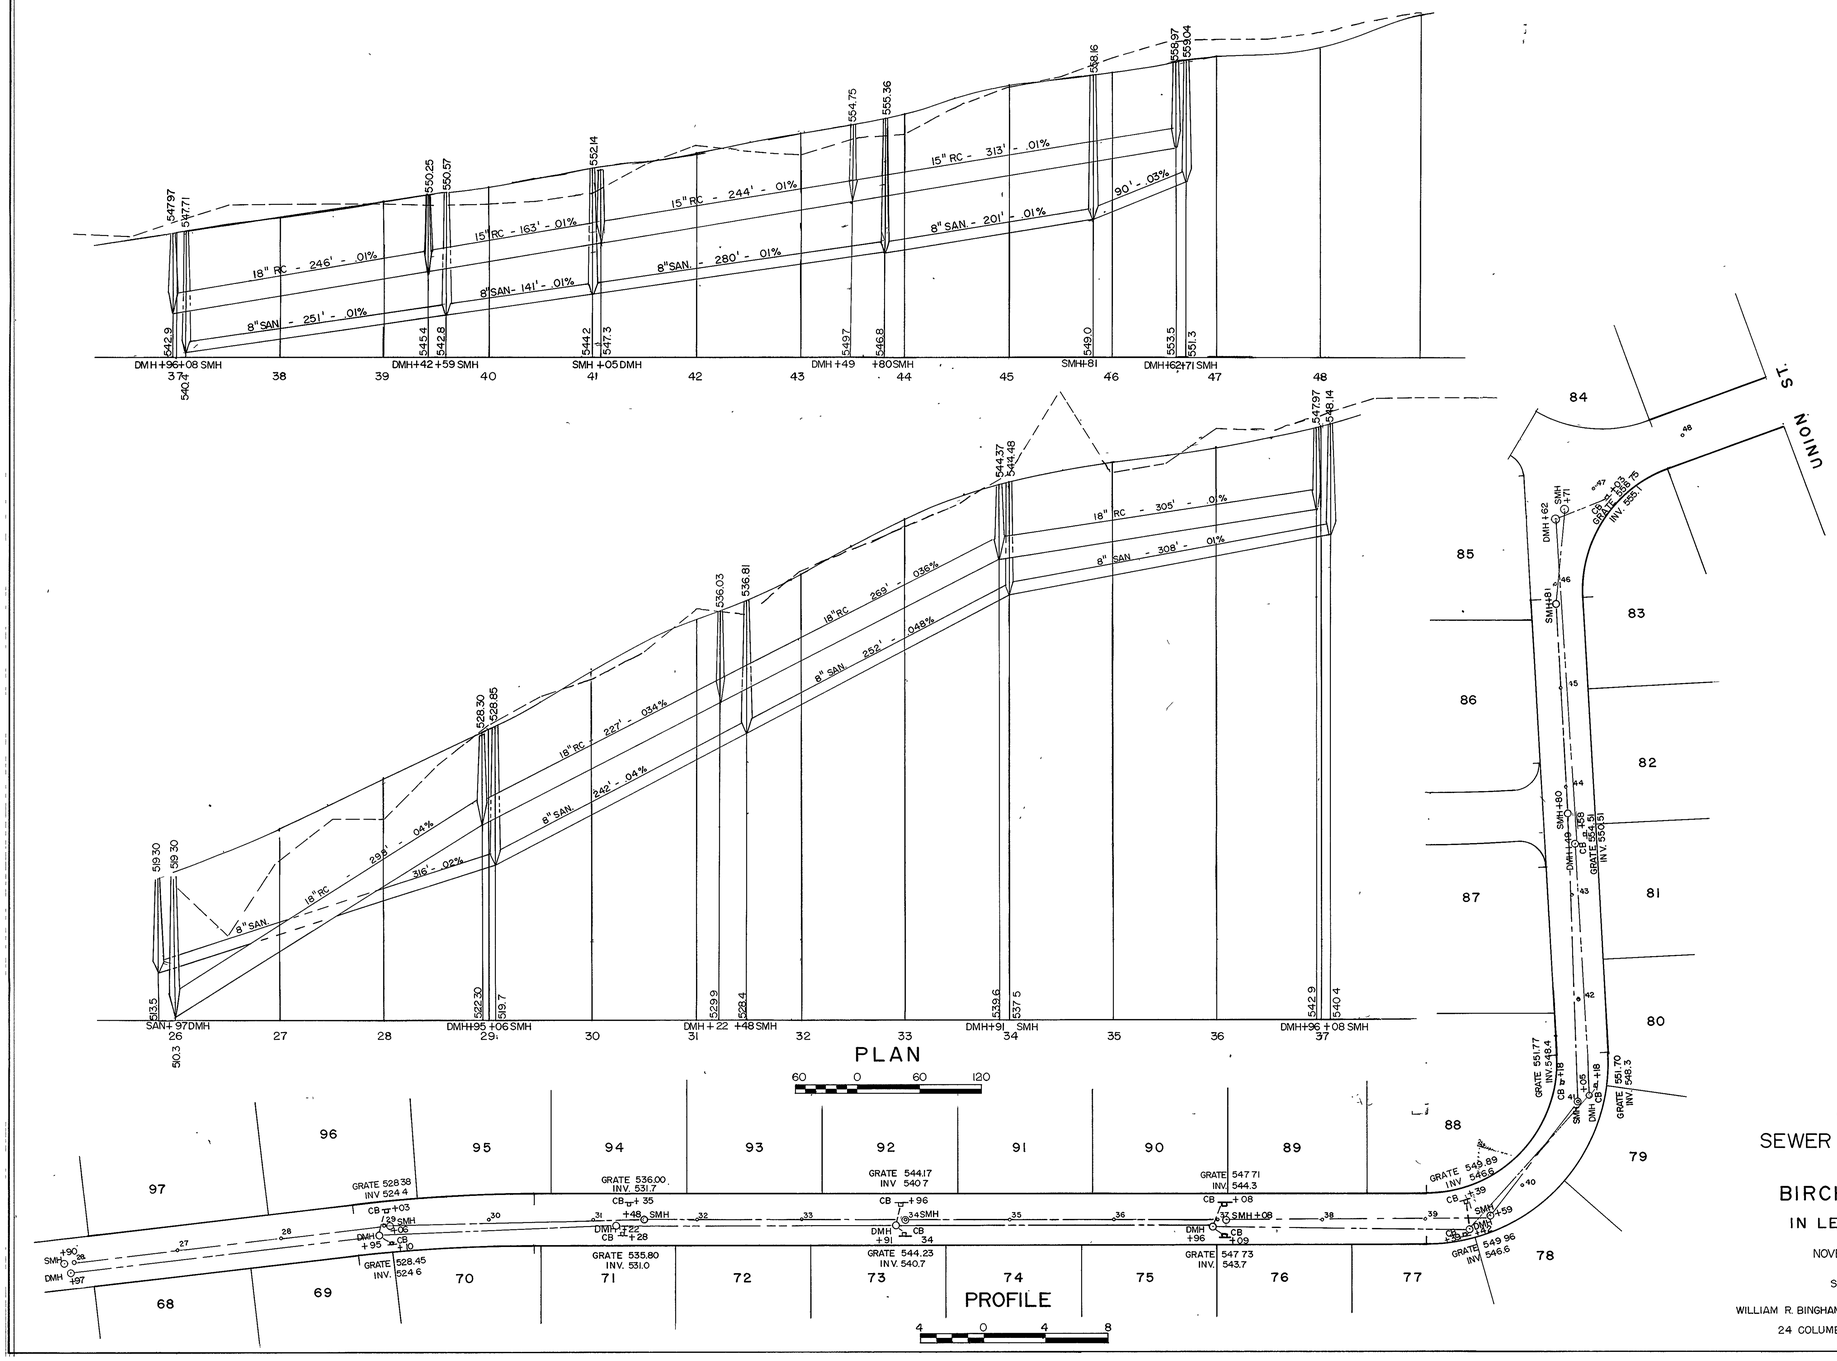

AS BUILT

SEWER PLAN & PROFILE

OF

BIRCHCROFT ROAD

IN LEOMINSTER, MASS.

NOVEMBER 24, 1987

SCALES AS SHOWN

WILLIAM R. BINGHAM & ASSOC.-REG. ENGRS. & SURVEYORS

24 COLUMBIA ST. — LEOMINSTER, MASS.

D-369.