D-373

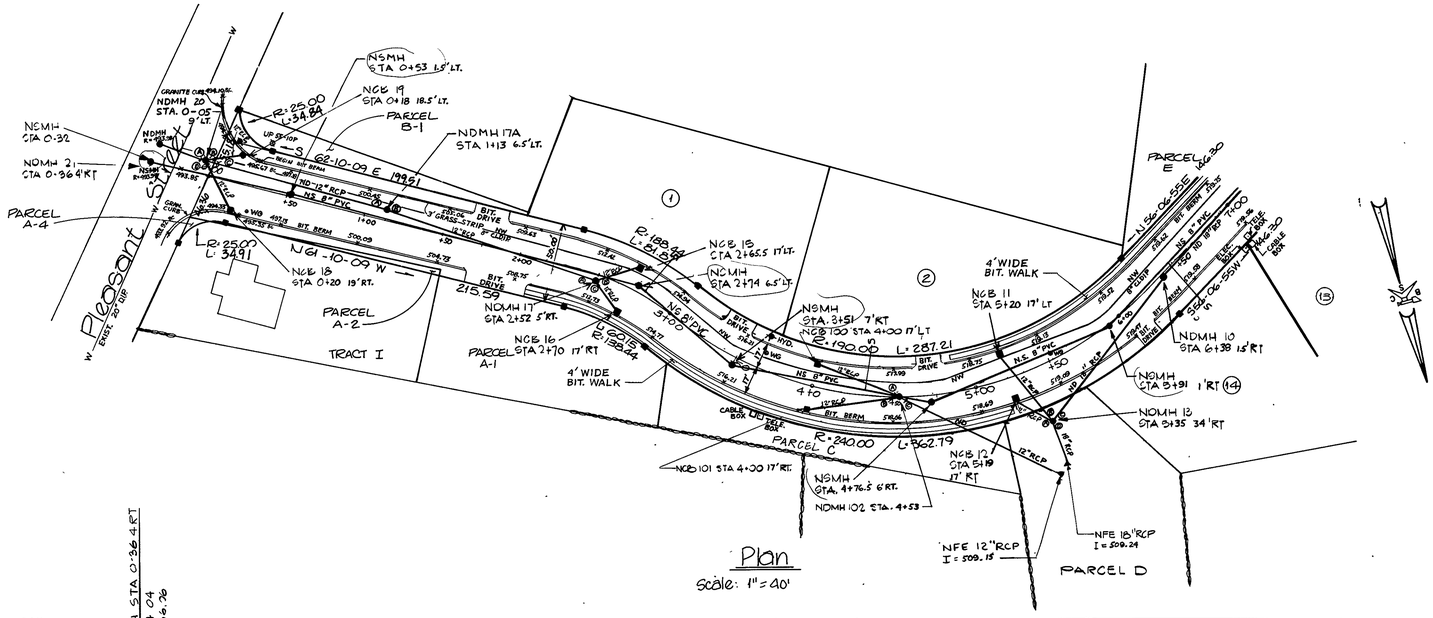

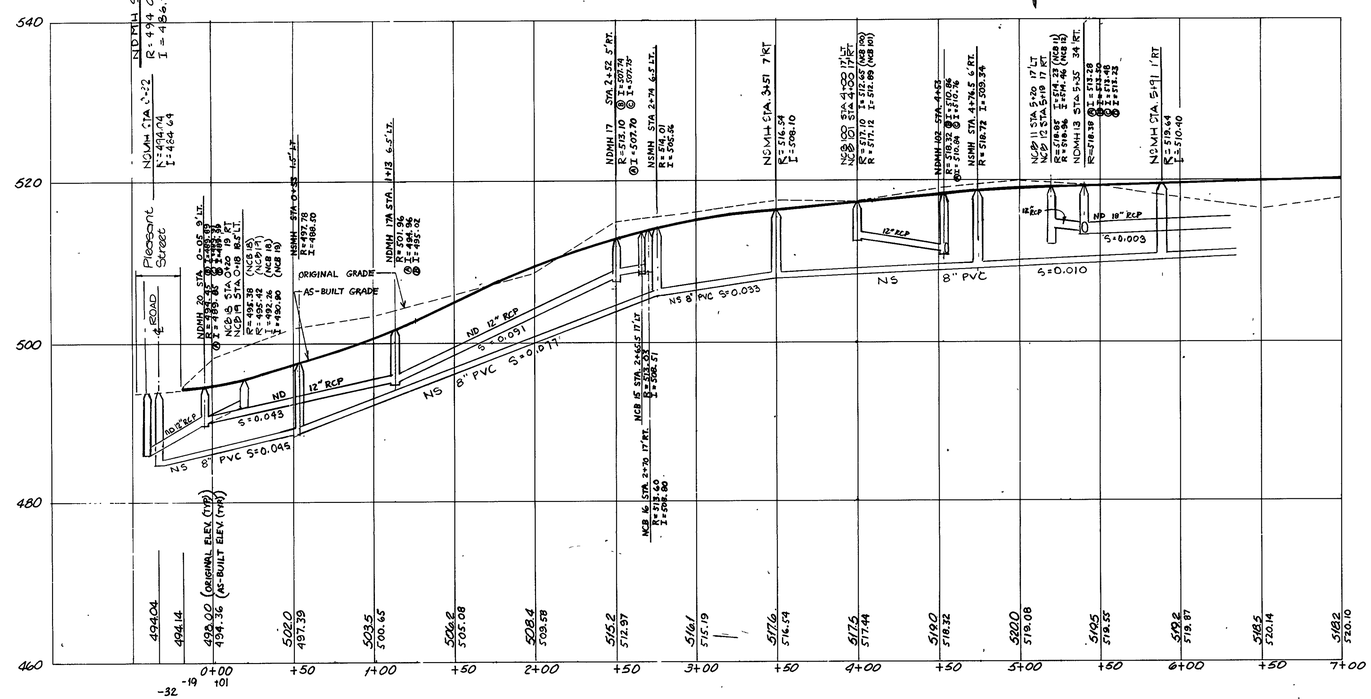

REVISIONS

NO	DATE	
1	2/24/87	REV PLAN & PROFILE SHT. No.
2	3/26/87	REV SAN. & DRAIN

REFERENCES

PROJECT TITLE

"OAKWIND HOLLOW"
SUBDIVISION
IN
LEOMINSTER, MASSACHUSETTS
(WORCESTER COUNTY)

OWNER/APPLICANT
BRAID PROPERTY, INC.
152 EAST BARE HILL ROAD
HARVARD, MASSACHUSETTS
01451

BSC
The BSC Group

Robinson & Fox
[redacted]
82 Thomas Street
Worcester MA
01608
617 756 6083

COMMONWEALTH OF MASSACHUSETTS
ADRIAN O'HARA DUMAS
No 33942
PROFESSIONAL SURVEYOR

"AS BUILT DRAWING"
SEWER & DRAIN
STA. 0+00 - 7+00

SCALE AS NOTED

DATE	JAN. 12, 1989
COMP DESIGN	C E S
CHECK	FAH / AD
DRAWN.	MCH
FIELD	WEB
FILE NO:	
DWG. NO:	831
JOB NO:	8-1736.00

1 of 2