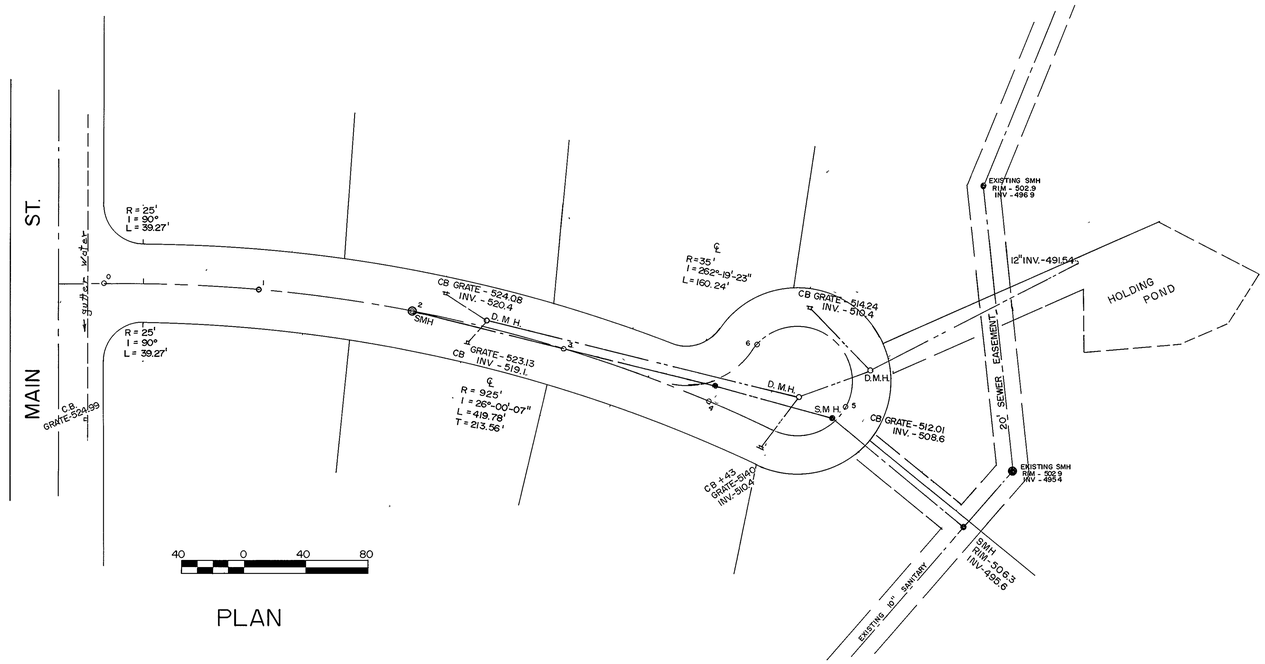

PLAN

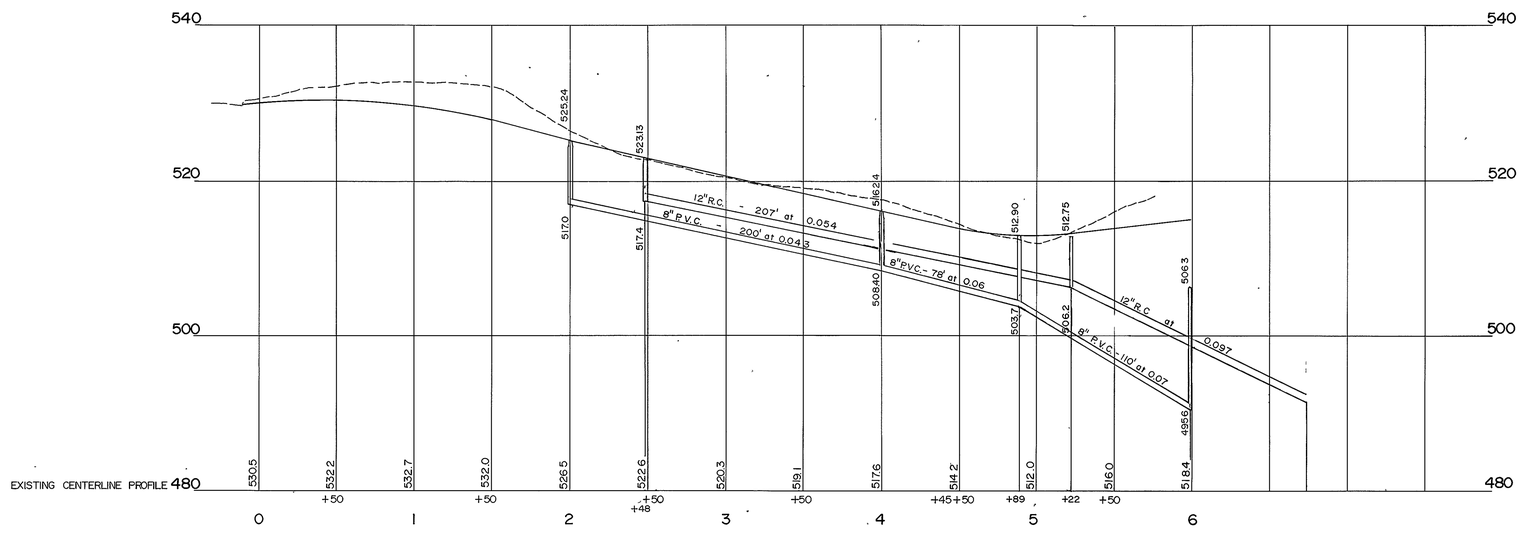

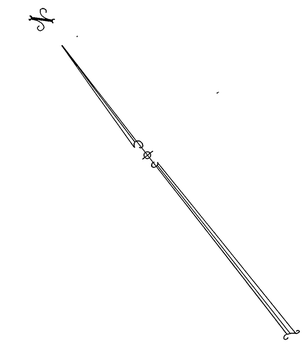

PROFILES

"AS-BUILT" PLAN

VERNON P. HOLMAN SR. ET UX

SEWER PLAN & PROFILE

OF

NORTH MEADOW ROAD

IN LEOMINSTER, MASS.

JUNE 5, 1990

SCALES AS SHOWN

WHITMAN & BINGHAM ASSOC. — REG. ENGINEERS & SURVEYORS
305 WHITNEY STREET — LEOMINSTER, MASS. 01453

21-D-6