D-377

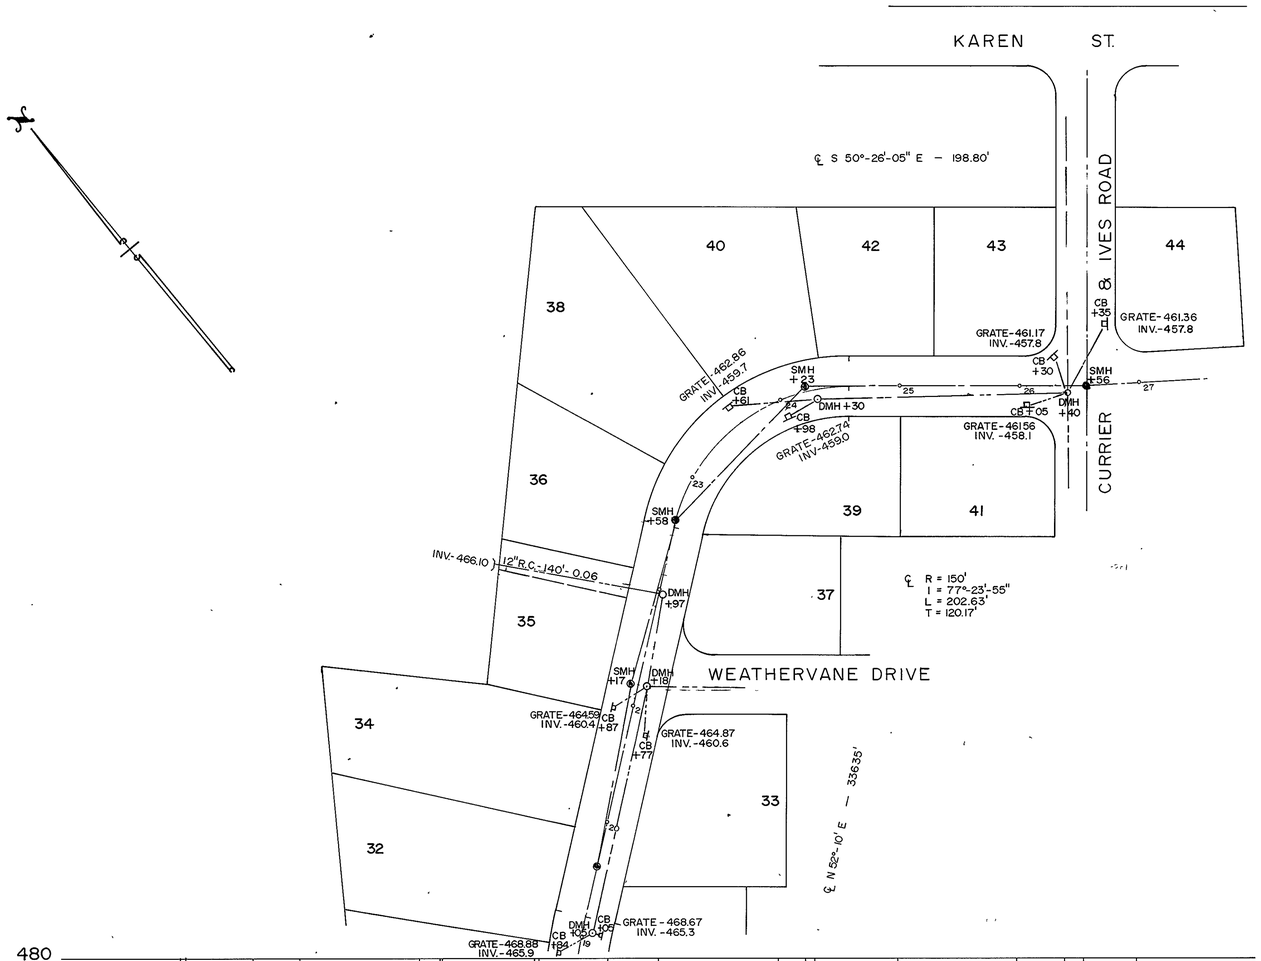

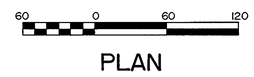

PLAN

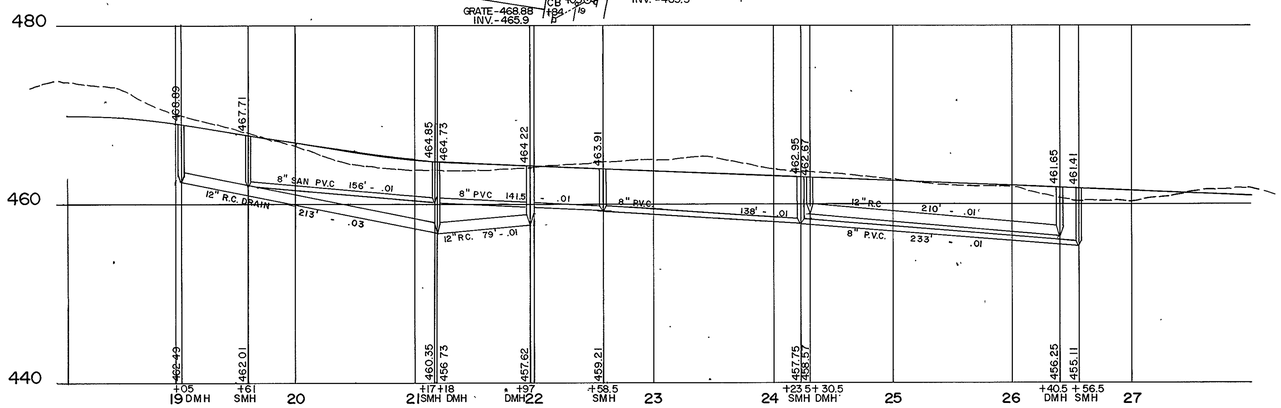

PROFILE

AS BUILT

SEWER PLAN & PROFILE

OF

JAMESTOWN ROAD

IN LEOMINSTER, MASS.

JUNE 2, 1988

SCALES AS SHOWN

WHITMAN & BINGHAM ASSOC–REG ENGRS. & SURVEYORS
305 WHITNEY ST. — LEOMINSTER, MASS.

SHEET 2 OF 2