D-378

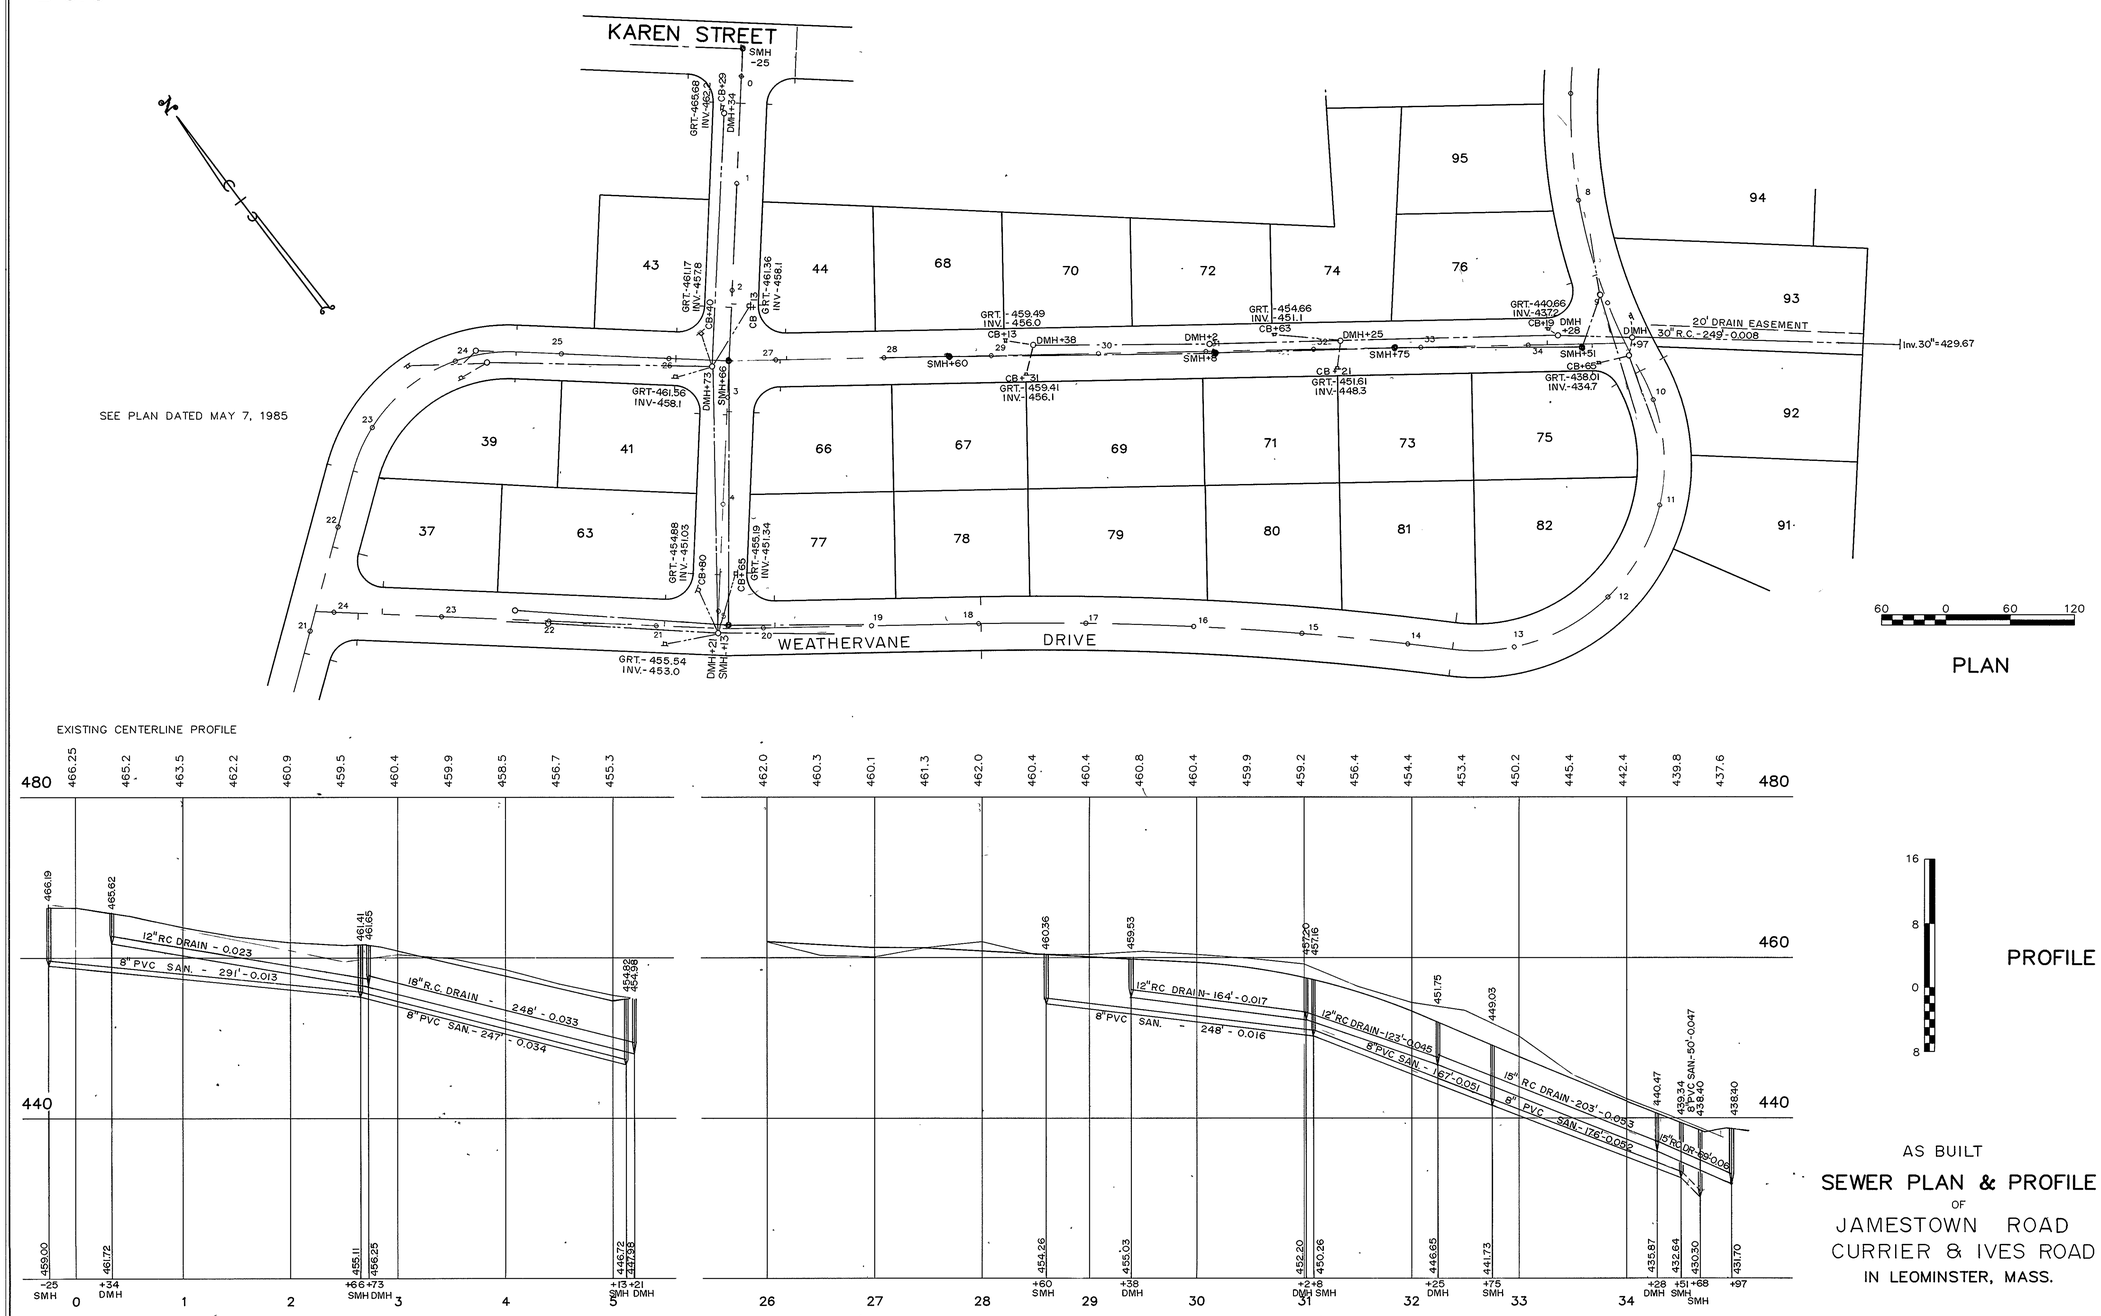

AS BUILT

SEWER PLAN & PROFILE

OF

JAMESTOWN ROAD
CURRIER & IVES ROAD
IN LEOMINSTER, MASS.

JUNE 30, 1990

SCALES AS SHOWN

WHITMAN & BINGHAM ASSOCIATES
305 WHITNEY STREET – LEOMINSTER, MASS. 01453