D-380

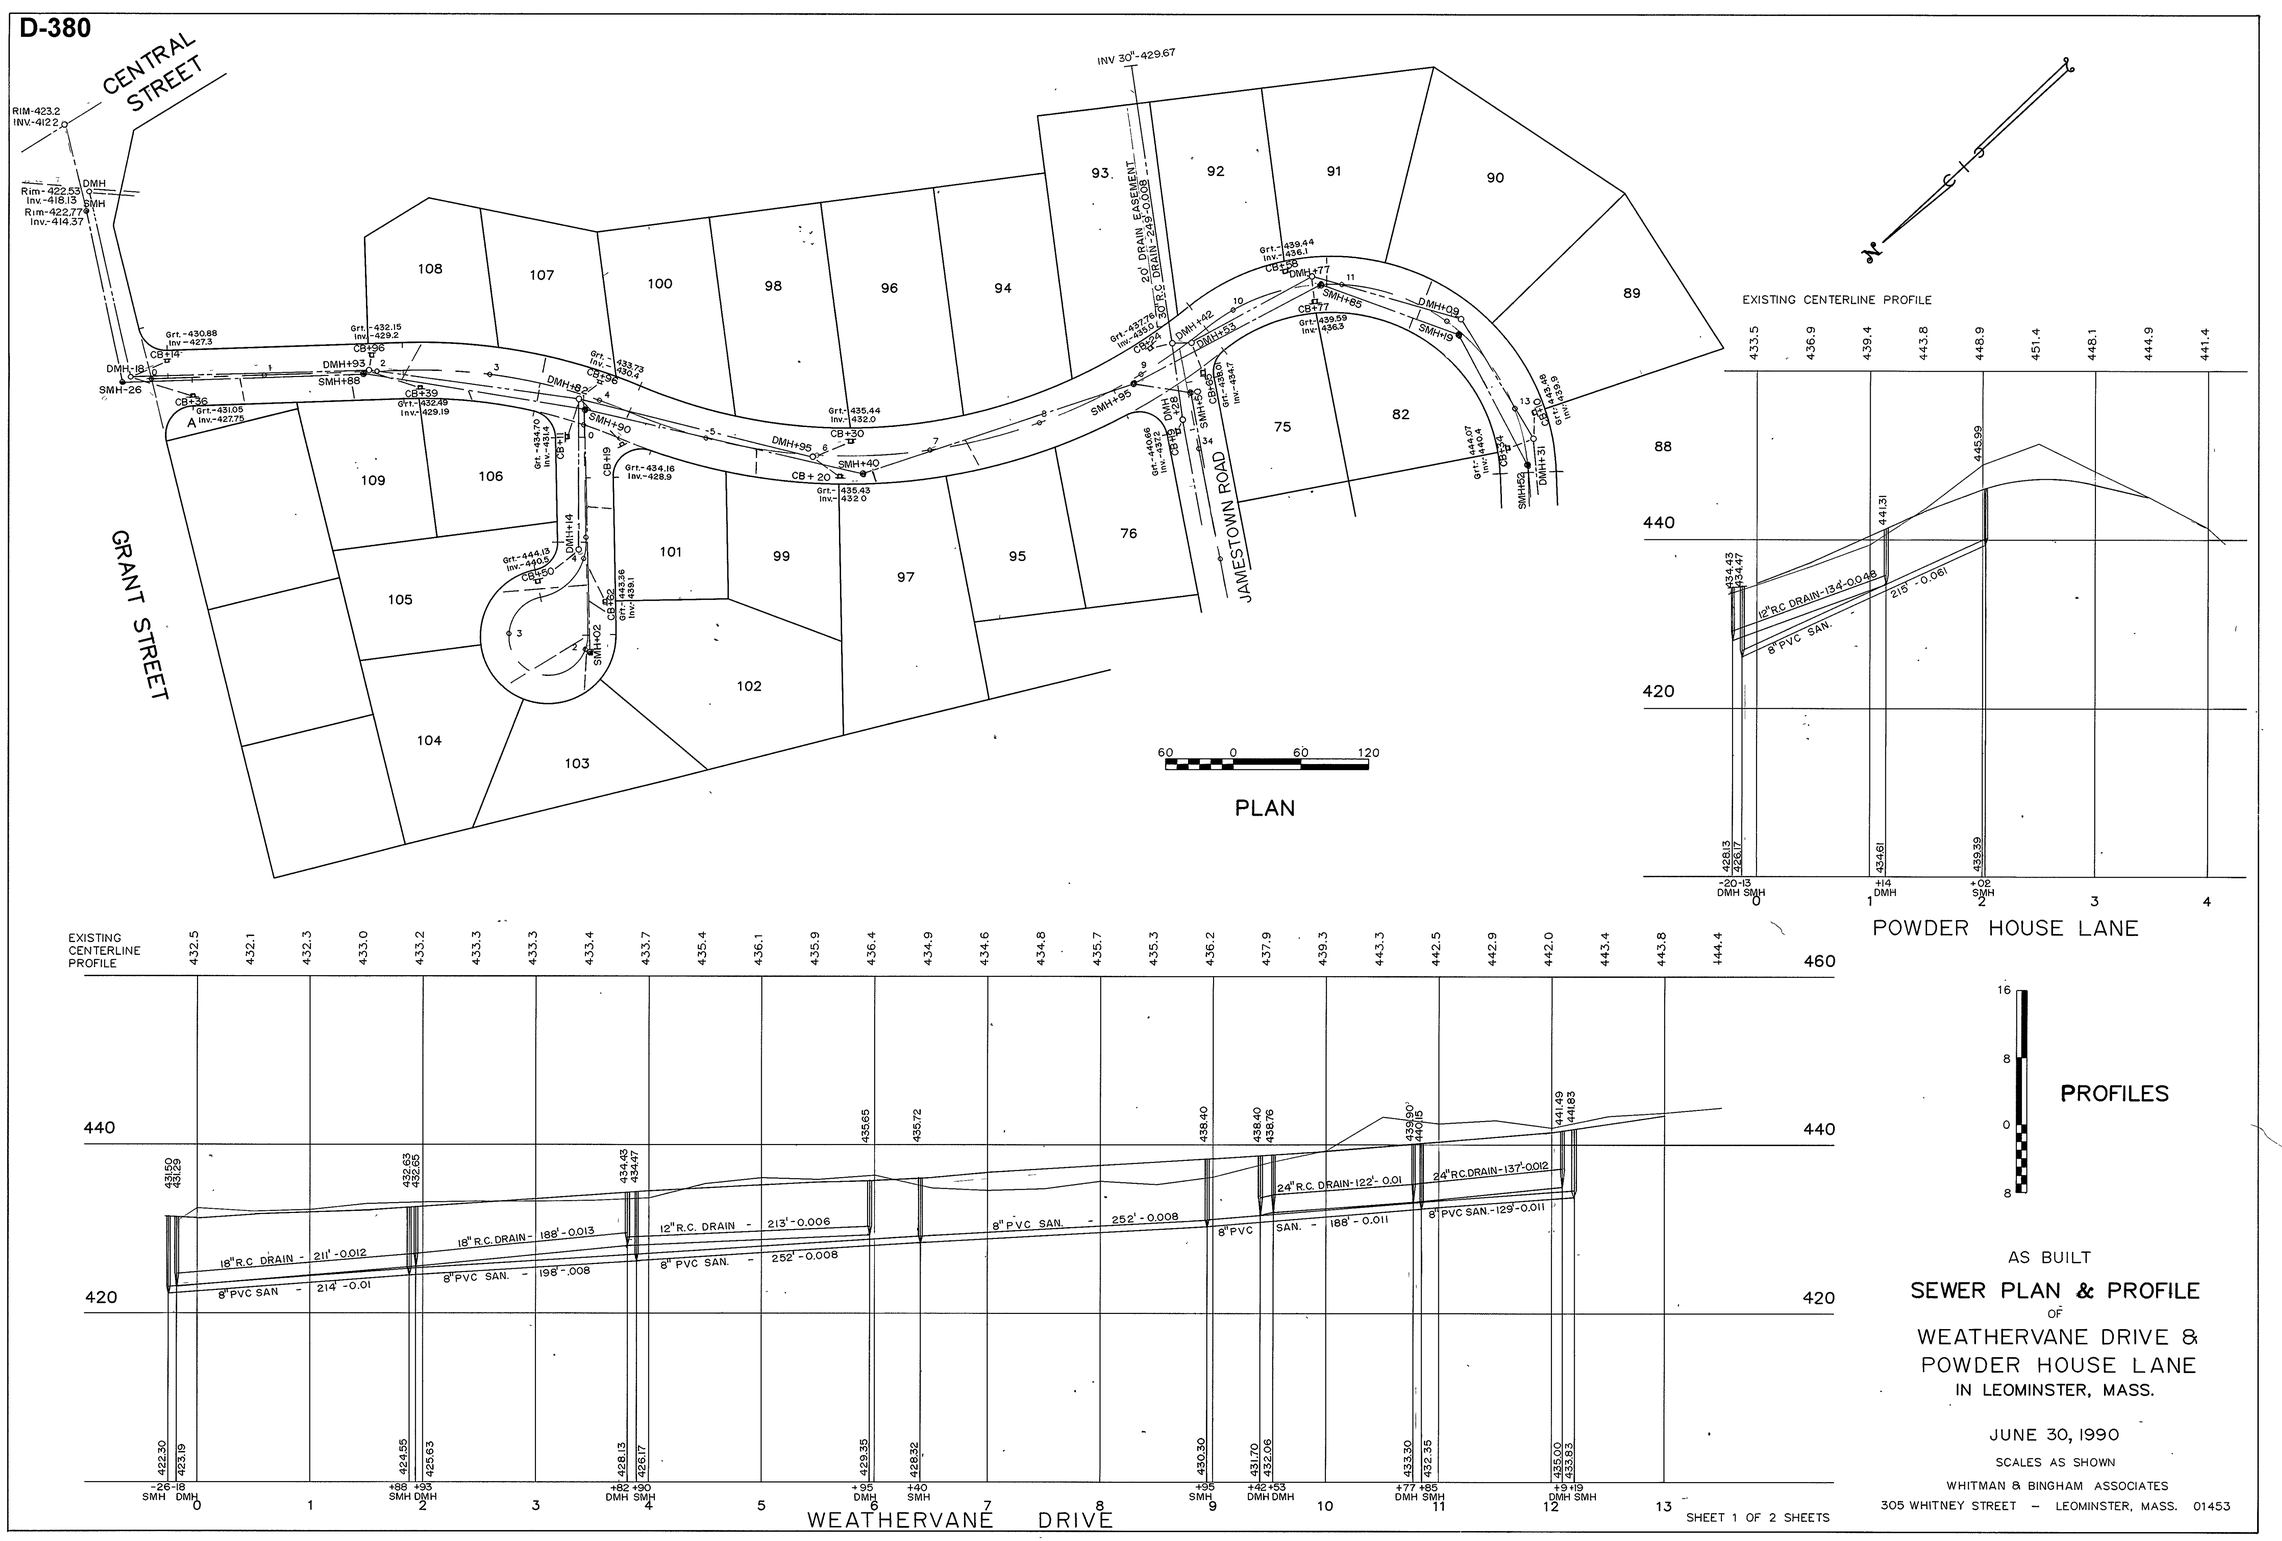

PROFILES

AS BUILT

SEWER PLAN & PROFILE

OF

WEATHERVANE DRIVE &

POWDER HOUSE LANE

IN LEOMINSTER, MASS.

JUNE 30, 1990

SCALES AS SHOWN

WHITMAN & BINGHAM ASSOCIATES

305 WHITNEY STREET – LEOMINSTER, MASS. 01453

SHEET 1 OF 2 SHEETS

D-380