D-381

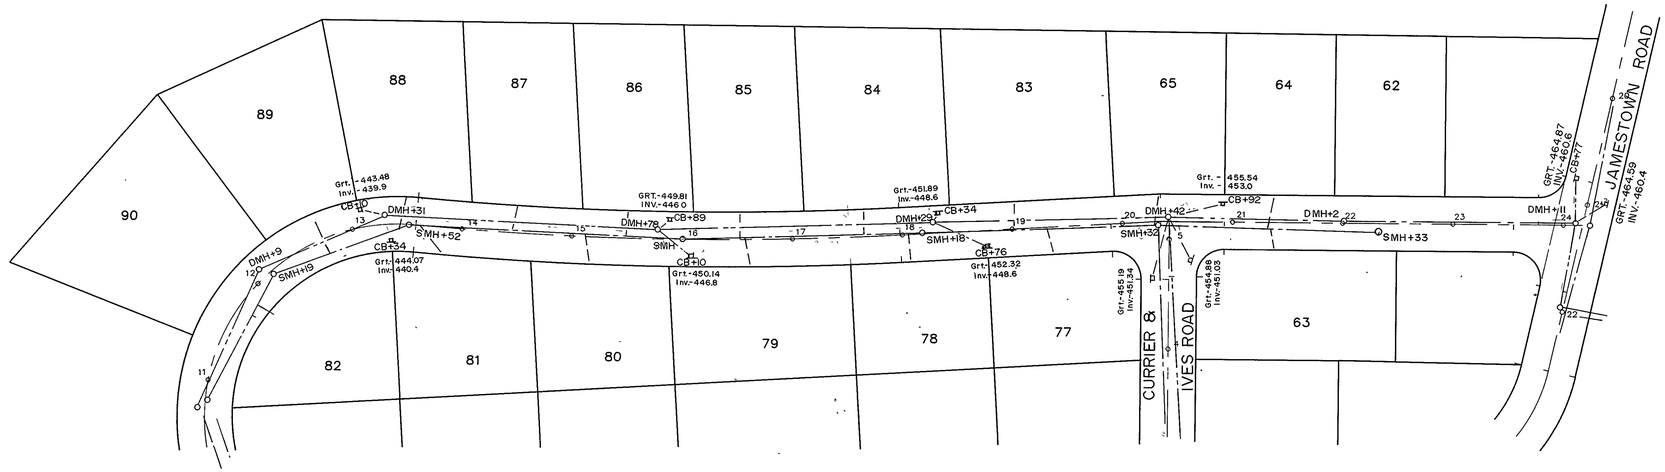


60 0 60 120

PLAN

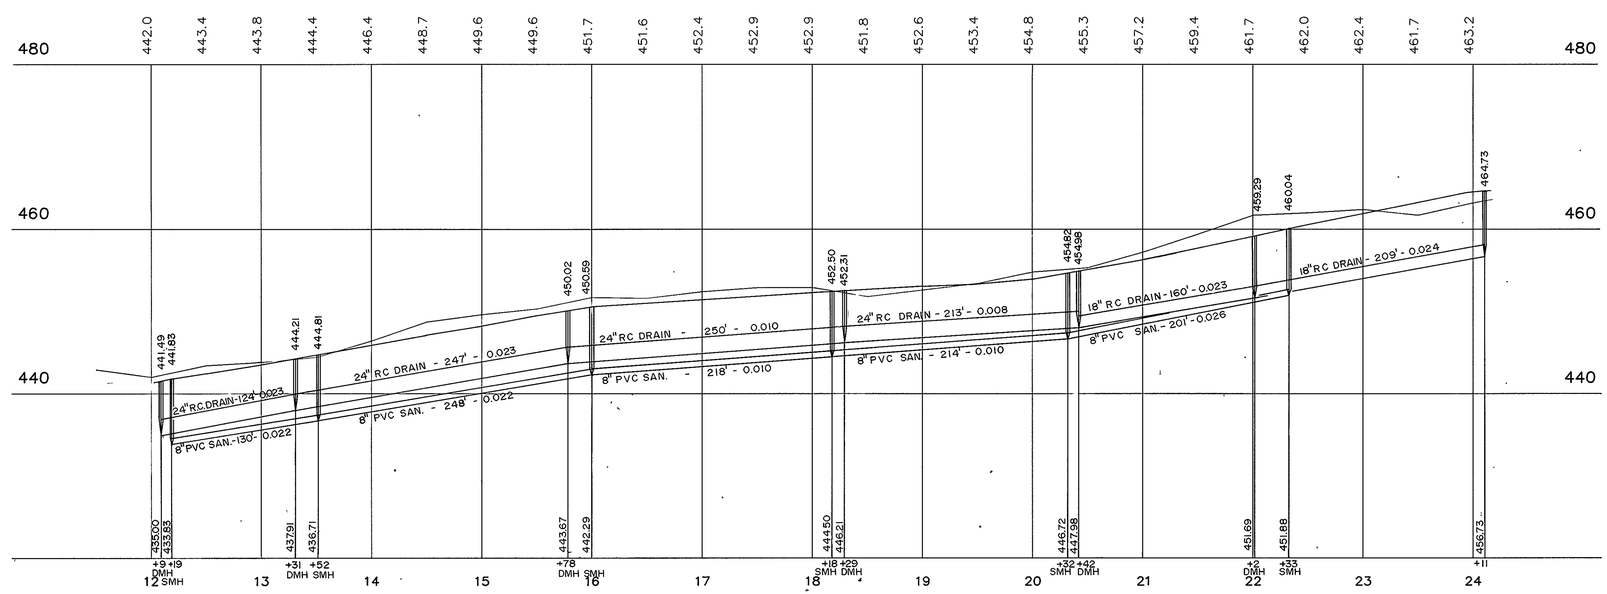


16 8 0 8

PROFILE

AS BUILT

SEWER PLAN & PROFILE

OF

WEATHERVANE DRIVE

IN LEOMINSTER, MASS.

JUNE 30, 1990

SCALES AS SHOWN

WHITMAN & BINGHAM ASSOCIATES

305 WHITNEY STREET – LEOMINSTER, MASS. 01453

SHEET 2 OF 2 SHEETS