D-382

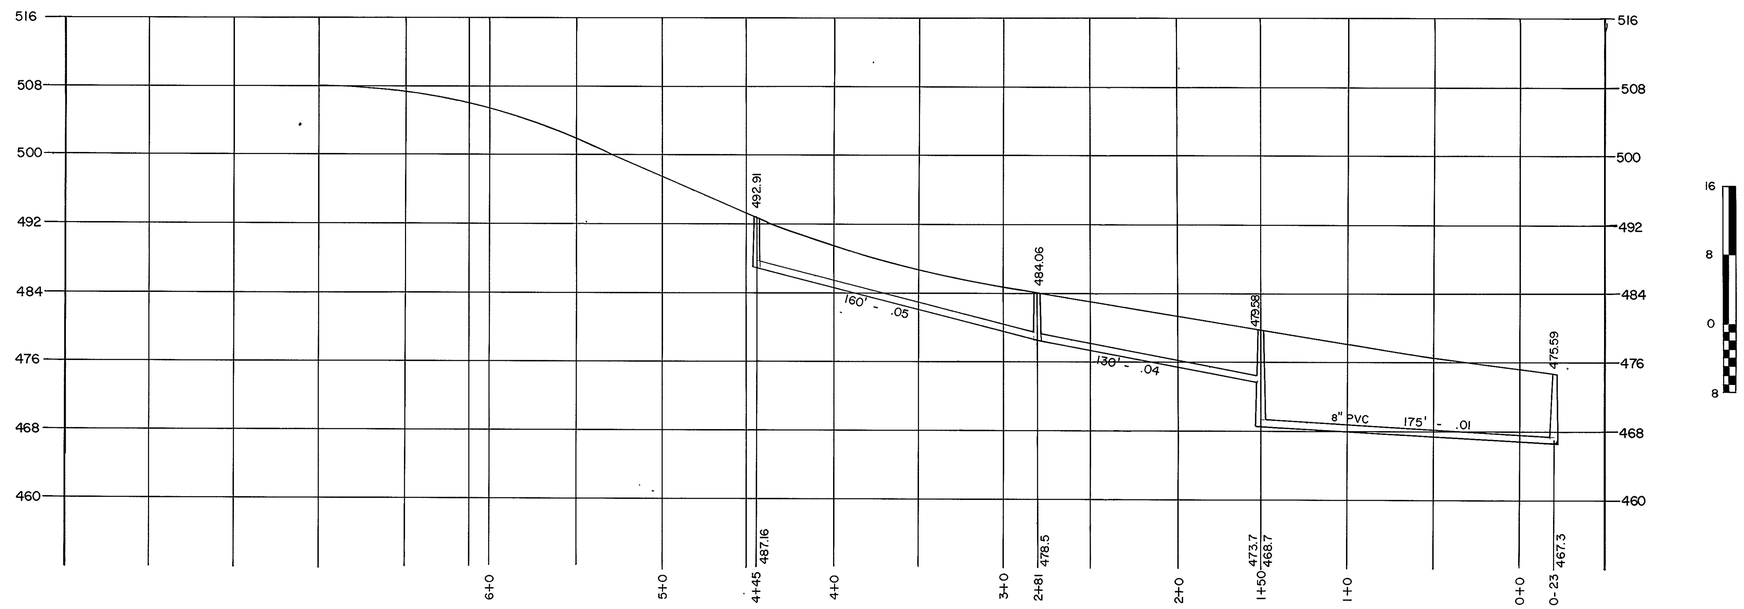

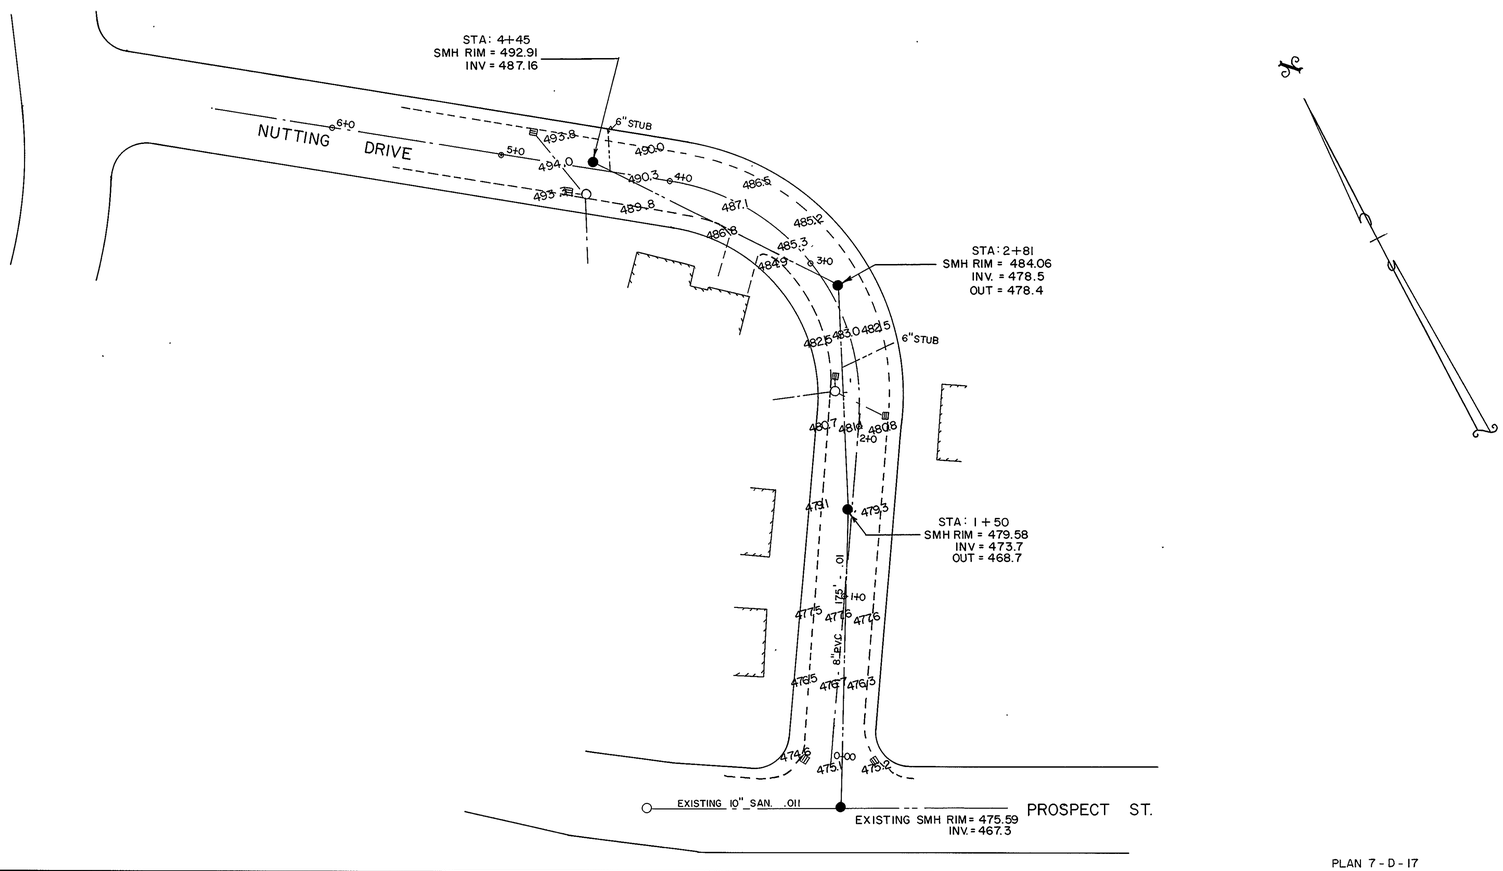

SEWER AS-BUILT

LAND IN LEOMINSTER, MASS.

OF

NUTTING DRIVE

AUGUST 29, 1991

40 0 40 80

WHITMAN & BINGHAM ASSOCIATES, INC.
REGISTERED PROFESSIONAL ENGINEERS & LAND SURVEYORS
305 WHITNEY STREET – LEOMINSTER, MASSACHUSETTS 01453

PLAN 7 - D - 17

D-382