D-384

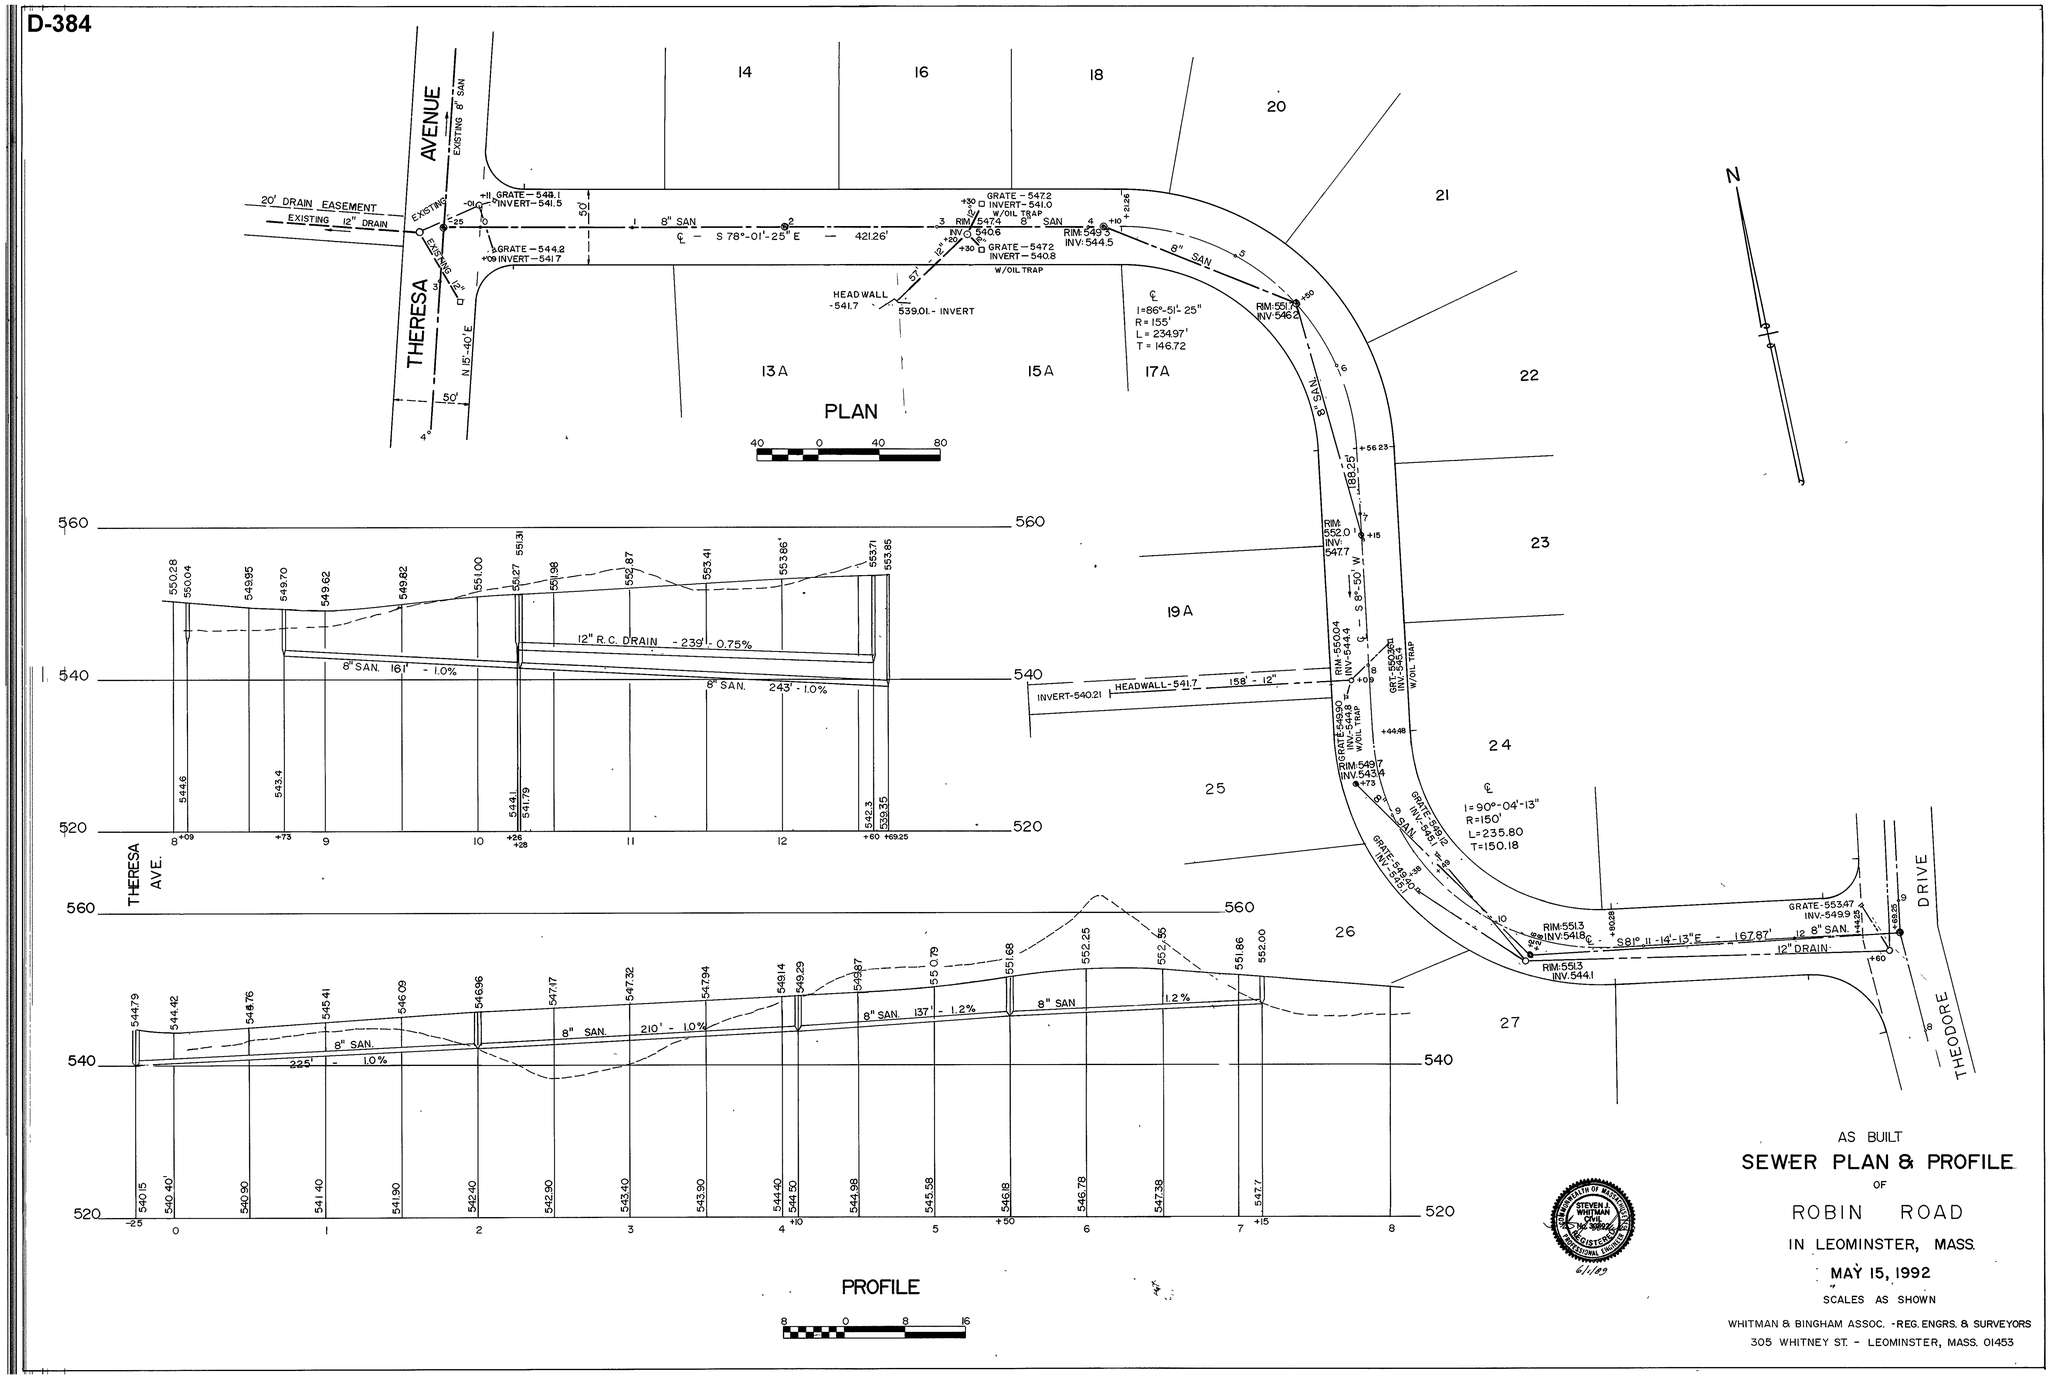

AS BUILT

SEWER PLAN & PROFILE

OF

ROBIN ROAD

IN LEOMINSTER, MASS.

MAY 15, 1992

SCALES AS SHOWN

WHITMAN & BINGHAM ASSOC. - REG. ENGRS. & SURVEYORS
305 WHITNEY ST. - LEOMINSTER, MASS. 01453

D-384