D-385

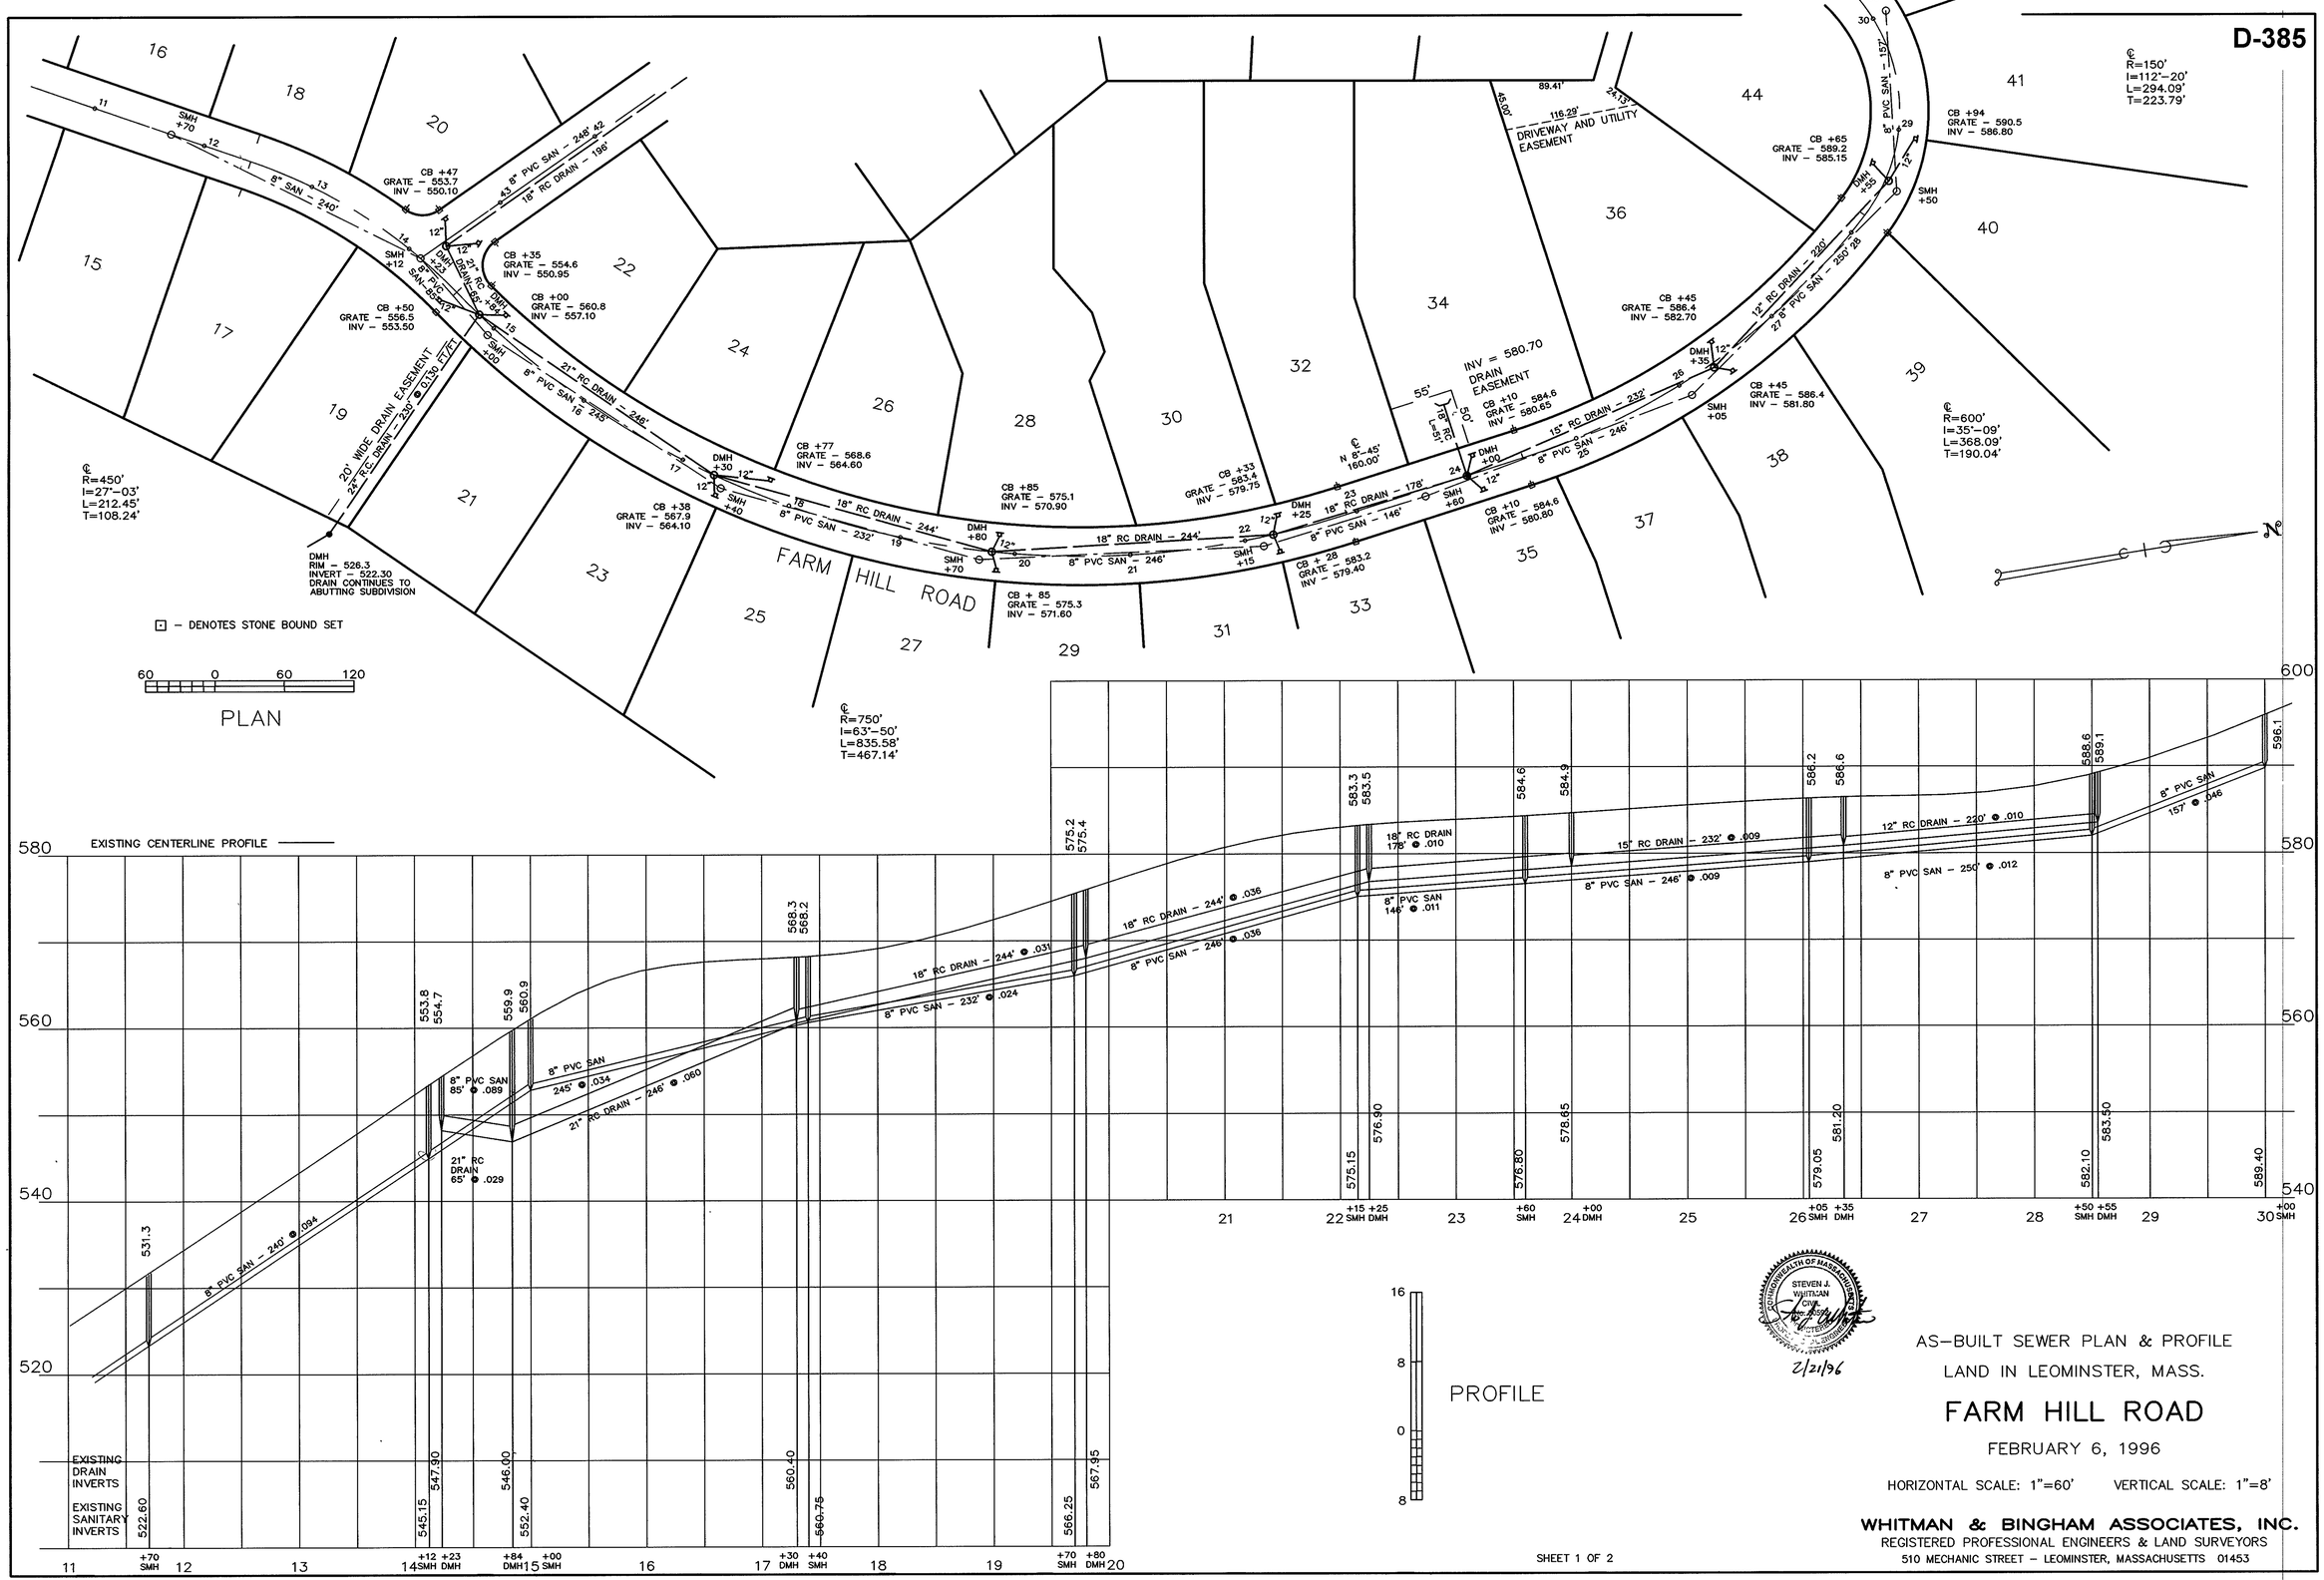

AS-BUILT SEWER PLAN & PROFILE

LAND IN LEOMINSTER, MASS.

FARM HILL ROAD

FEBRUARY 6, 1996

HORIZONTAL SCALE: 1"=60' VERTICAL SCALE: 1"=8'

WHITMAN & BINGHAM ASSOCIATES, INC.

REGISTERED PROFESSIONAL ENGINEERS & LAND SURVEYORS

510 MECHANIC STREET – LEOMINSTER, MASSACHUSETTS 01453

21-D-7

D-385