D-393

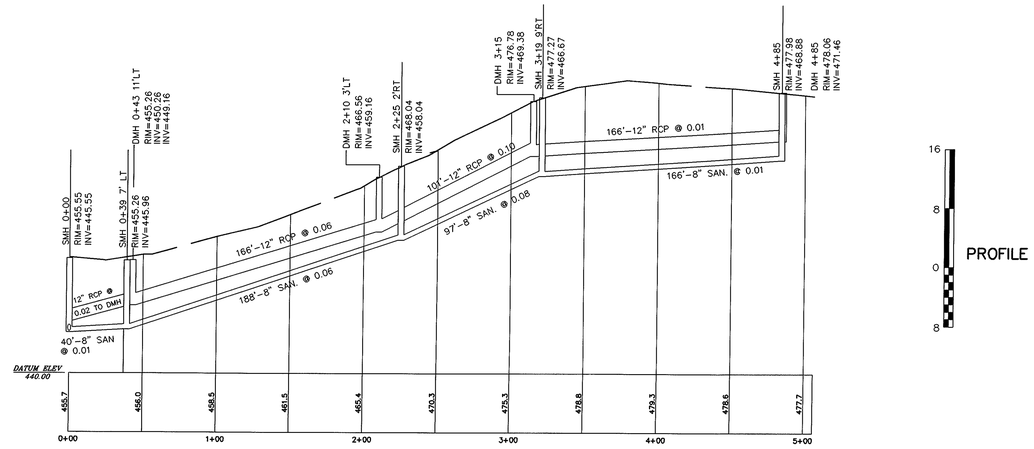

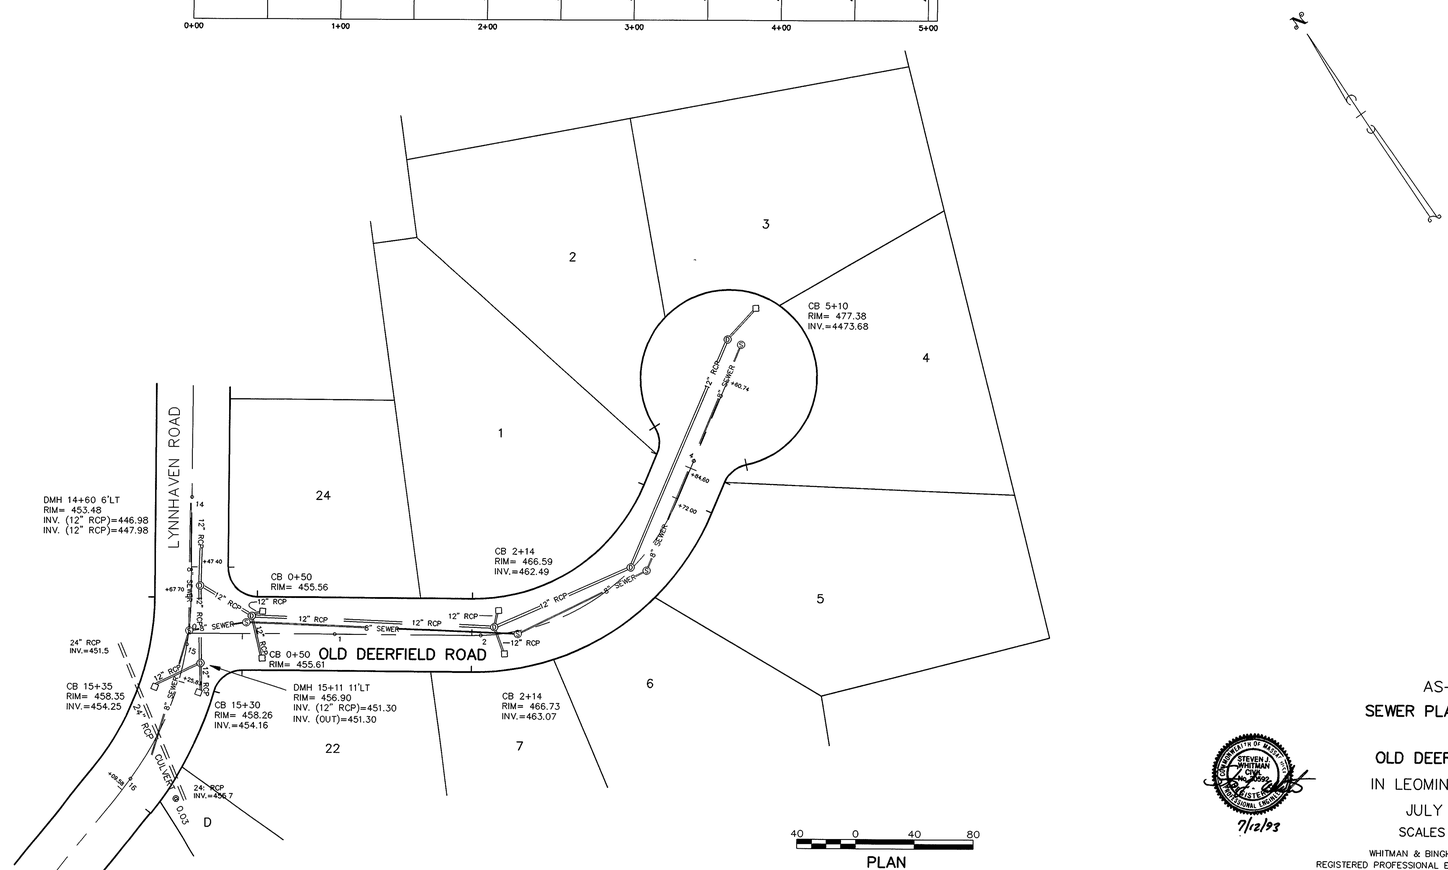

AS-BUILT

SEWER PLAN & PROFILE

OF

OLD DEERFIELD ROAD

IN LEOMINSTER, MASS.

JULY 8, 1993

SCALES AS SHOWN

WHITMAN & BINGHAM ASSOCIATES, INC.
REGISTERED PROFESSIONAL ENGINEERS AND LAND SURVEYORS
305 WHITNEY STREET, LEOMINSTER, MASS. 01453

24-D-25

D-393