D-395

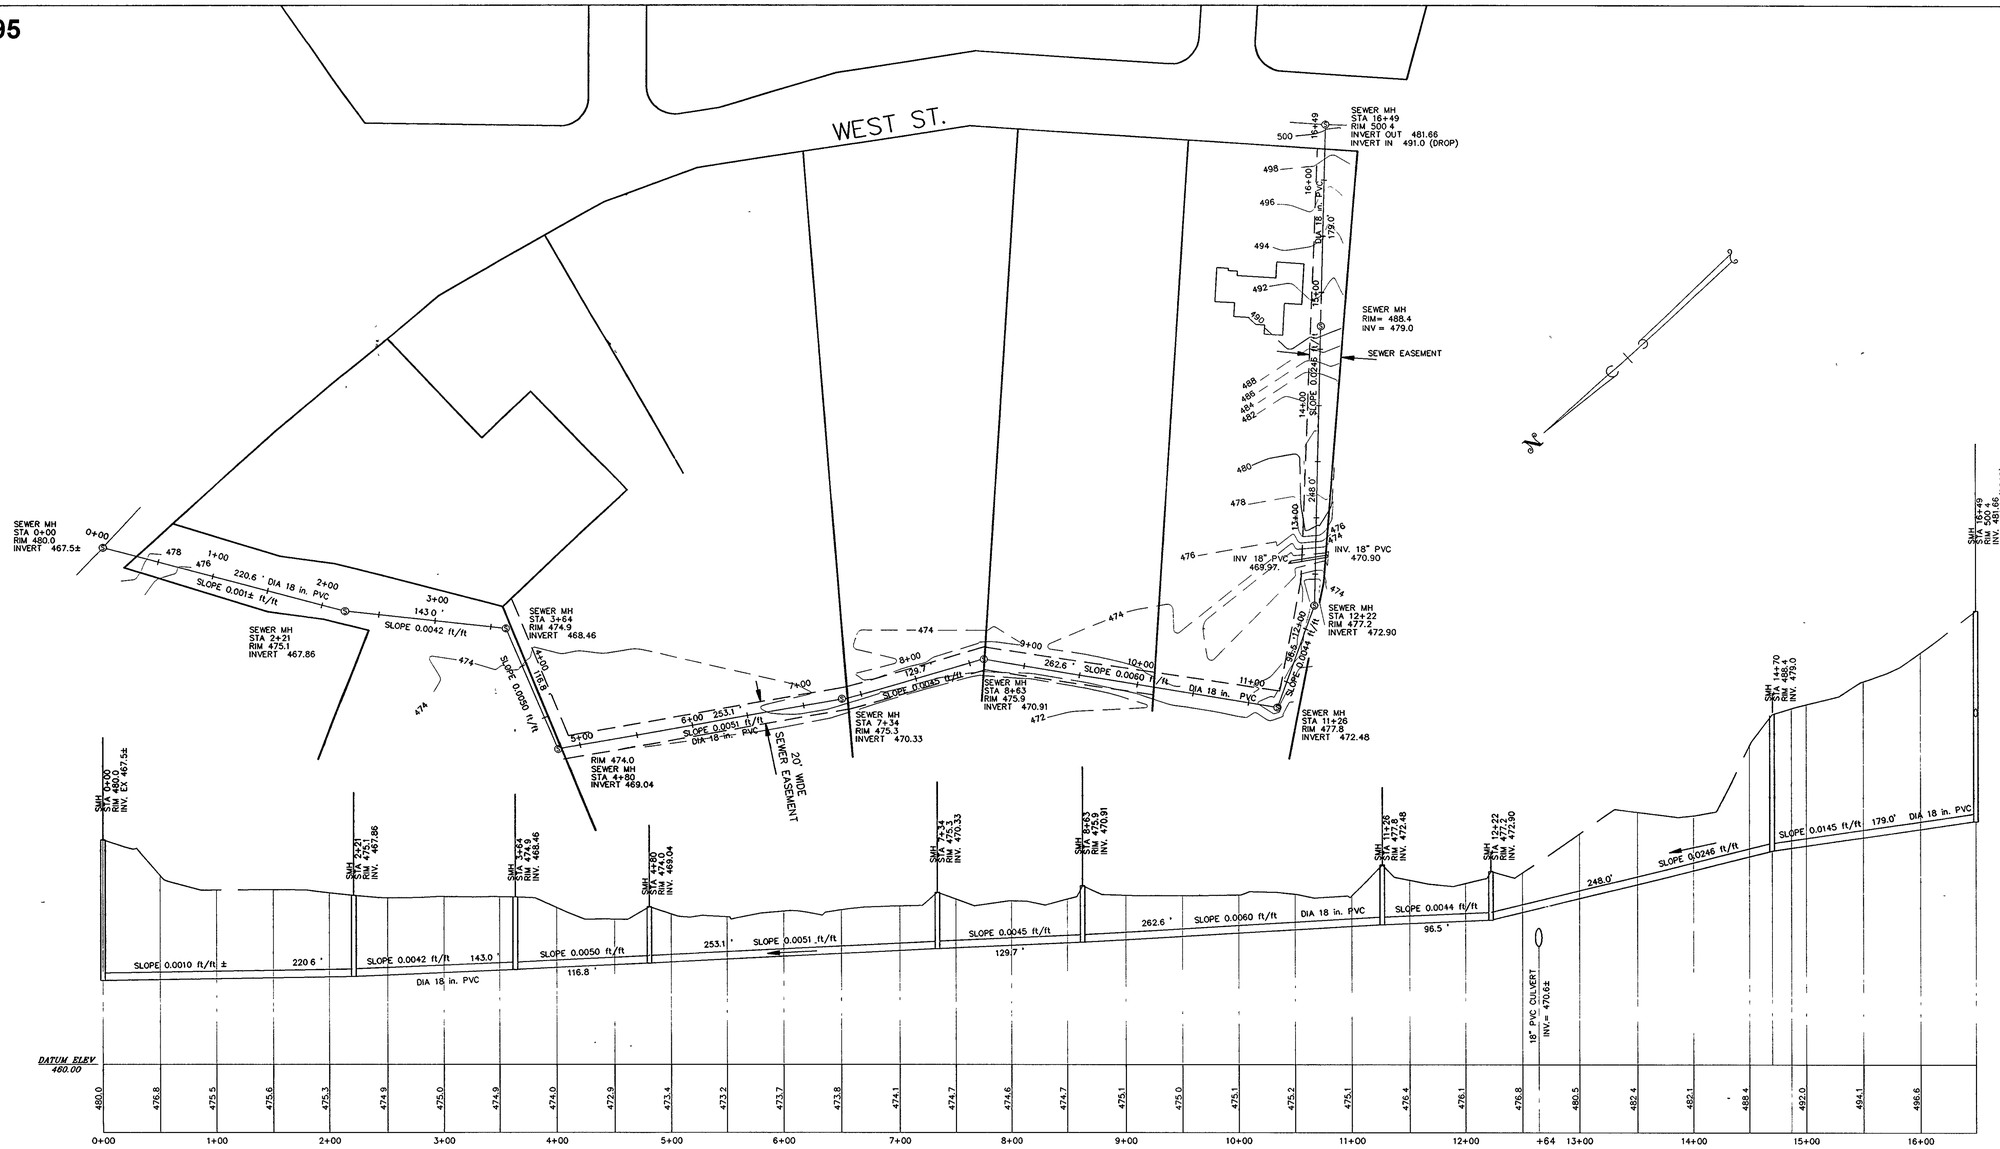

PROFILE

SCALE: 1"= 60 FT. HORIZ. 1"= 6 FT. VERT.

WEST STREET –ROCKWELL POND

SEWER ASBUILT

LAND IN LEOMINSTER, MASS.

FOR

MCCARTY ASSOCIATES

APRIL 20, 1995

60 0 60 120

WHITMAN & BINGHAM ASSOCIATES, IN
REGISTERED PROFESSIONAL ENGINEERS & LAND SURVEYORS
510 MECHANIC STREET – LEOMINSTER, MASSACHUSETTS 01453

PLAN 17–29

D-395