D-397

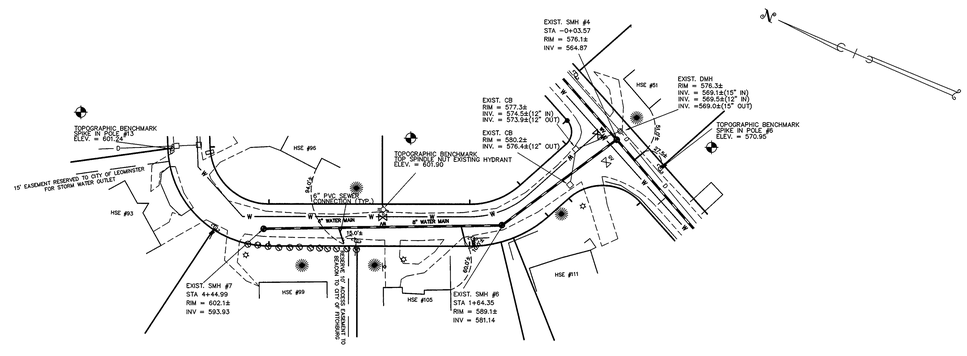

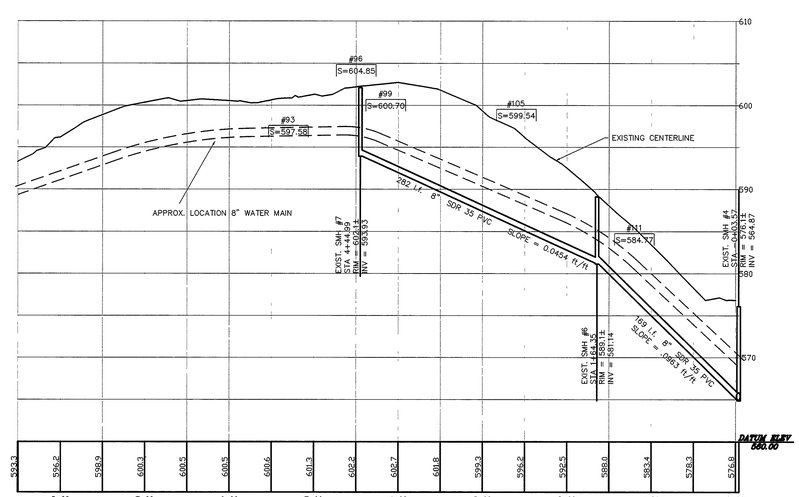

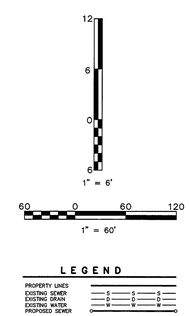

AS-BUILT SEWER PLAN & PROFILE

LAND IN LEOMINSTER, MASS.

SUNRISE AVENUE

APRIL 9, 1998

1" = 60' HORIZONTAL 1" = 6' VERTICAL

WHITMAN & BINGHAM ASSOCIATES, INC.
REGISTERED PROFESSIONAL ENGINEERS & LAND SURVEYORS
510 MECHANIC STREET – LEOMINSTER, MASSACHUSETTS 01453

4-L-212A