D-400

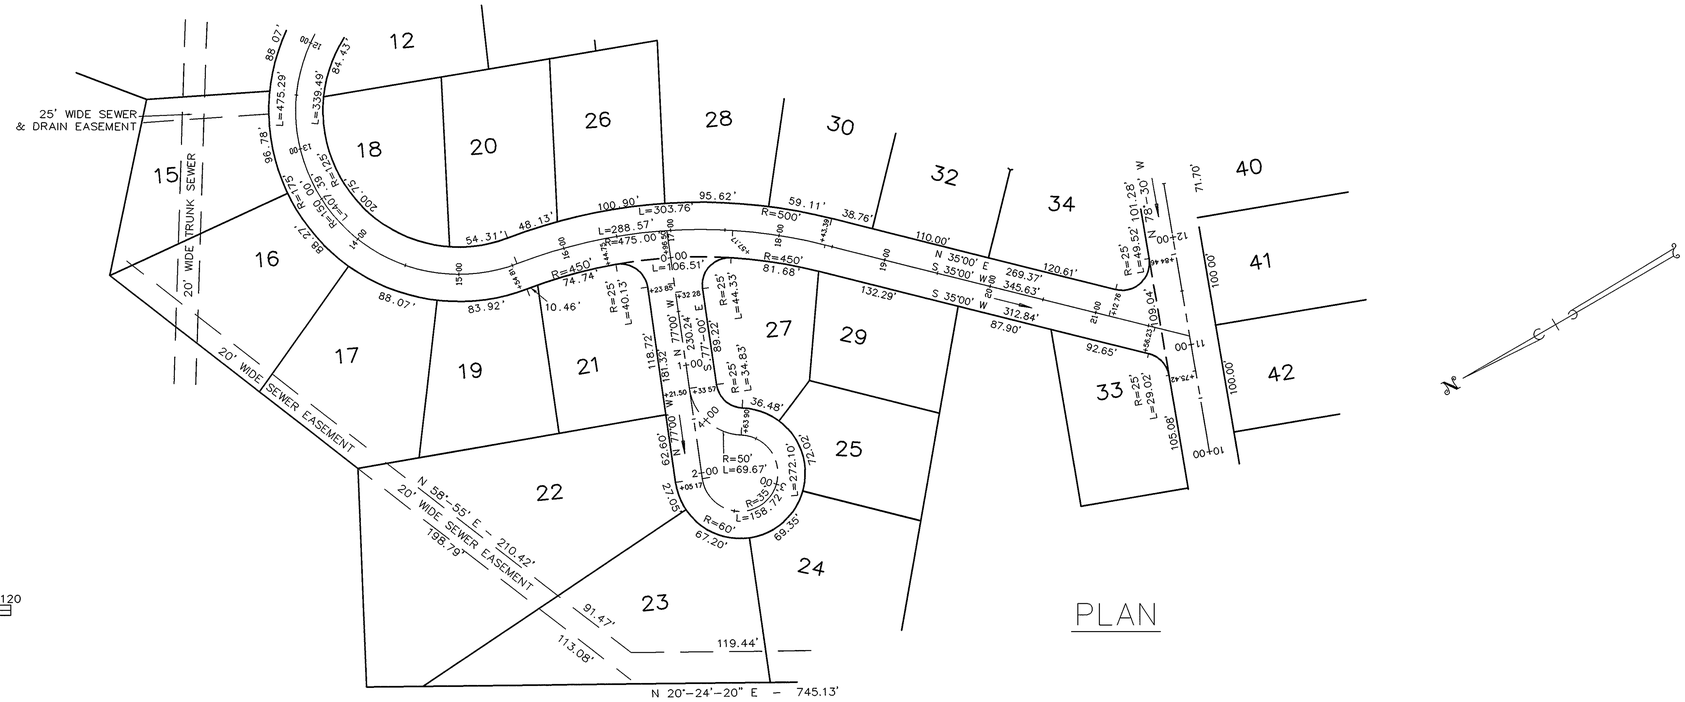

60 0 60 120

1" = 60' HORIZ.

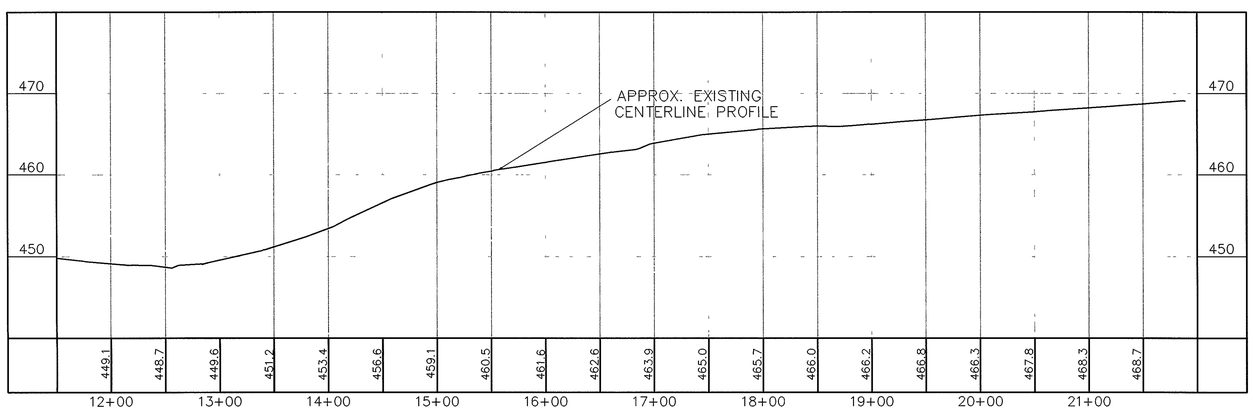

WILDFLOWER RD.

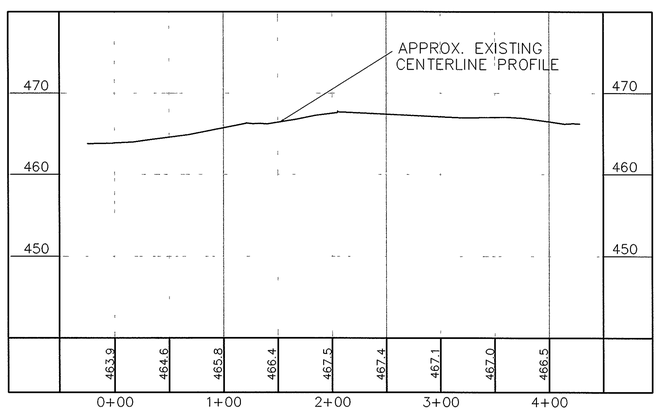

QUAIL RUN

16
8
0
8

1" = 8' VERT.

PROFILE

AS-BUILT STREET PLAN & PROFILE

LAND IN LEOMINSTER, MASS

WILDFLOWER ROAD & QUAIL RUN

APRIL 4, 1997

HORIZONTAL SCALE: 1"=60' VERTICAL SCALE: 1"=8'

4/4/97

WHITMAN & BINGHAM ASSOCIATES, INC.
REGISTERED PROFESSIONAL ENGINEERS & LAND SURVEYORS
510 MECHANIC STREET - LEOMINSTER, MASSACHUSETTS 01453

20-D-34

D-400