D-402

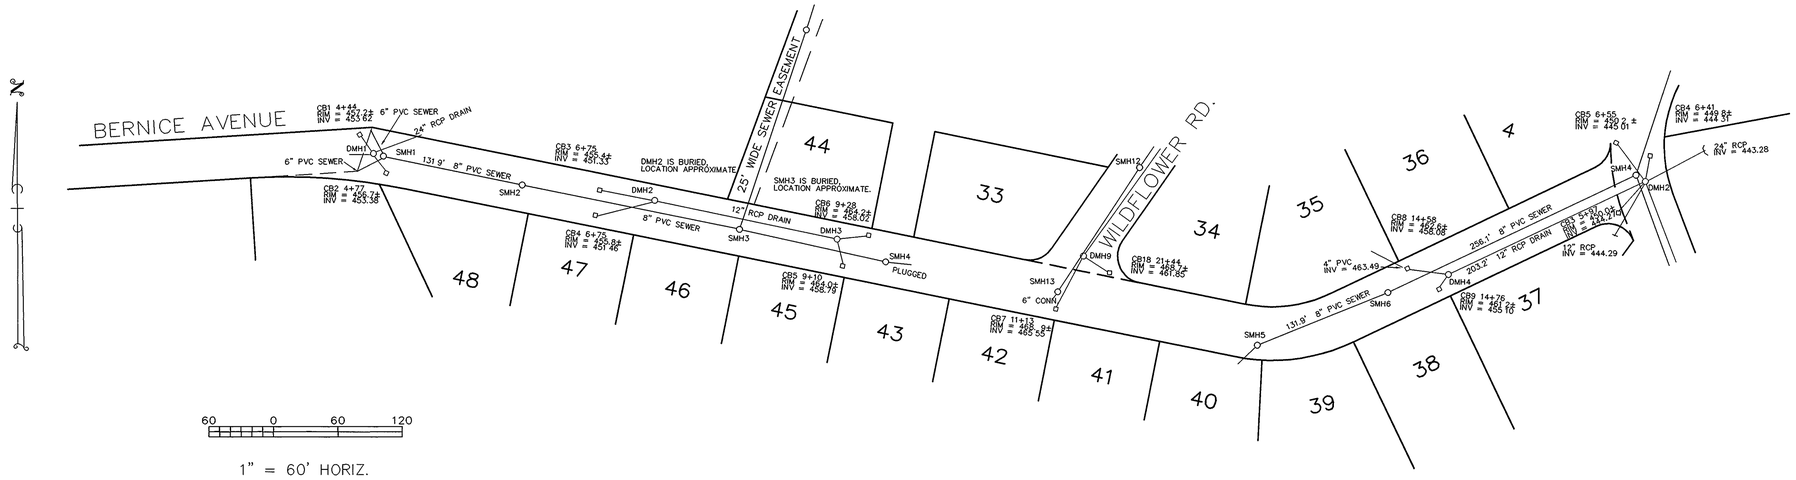

PLAN

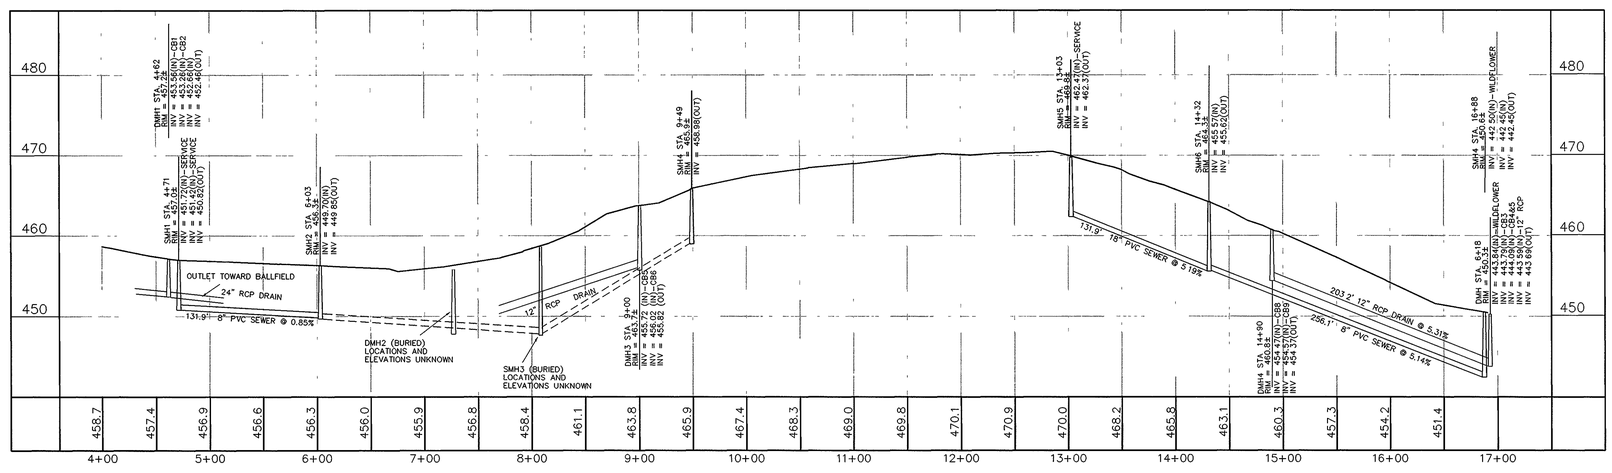

PROFILE

AS-BUILT SEWER PLAN & PROFILE

LAND IN LEOMINSTER, MASS

BERNICE AVENUE

APRIL 4, 1997

HORIZONTAL SCALE: 1"=60' VERTICAL SCALE: 1"=8'

4/10/97

WHITMAN & BINGHAM ASSOCIATES, INC.

REGISTERED PROFESSIONAL ENGINEERS & LAND SURVEYORS

510 MECHANIC STREET - LEOMINSTER, MASSACHUSETTS 01453

20-D-34