D-403

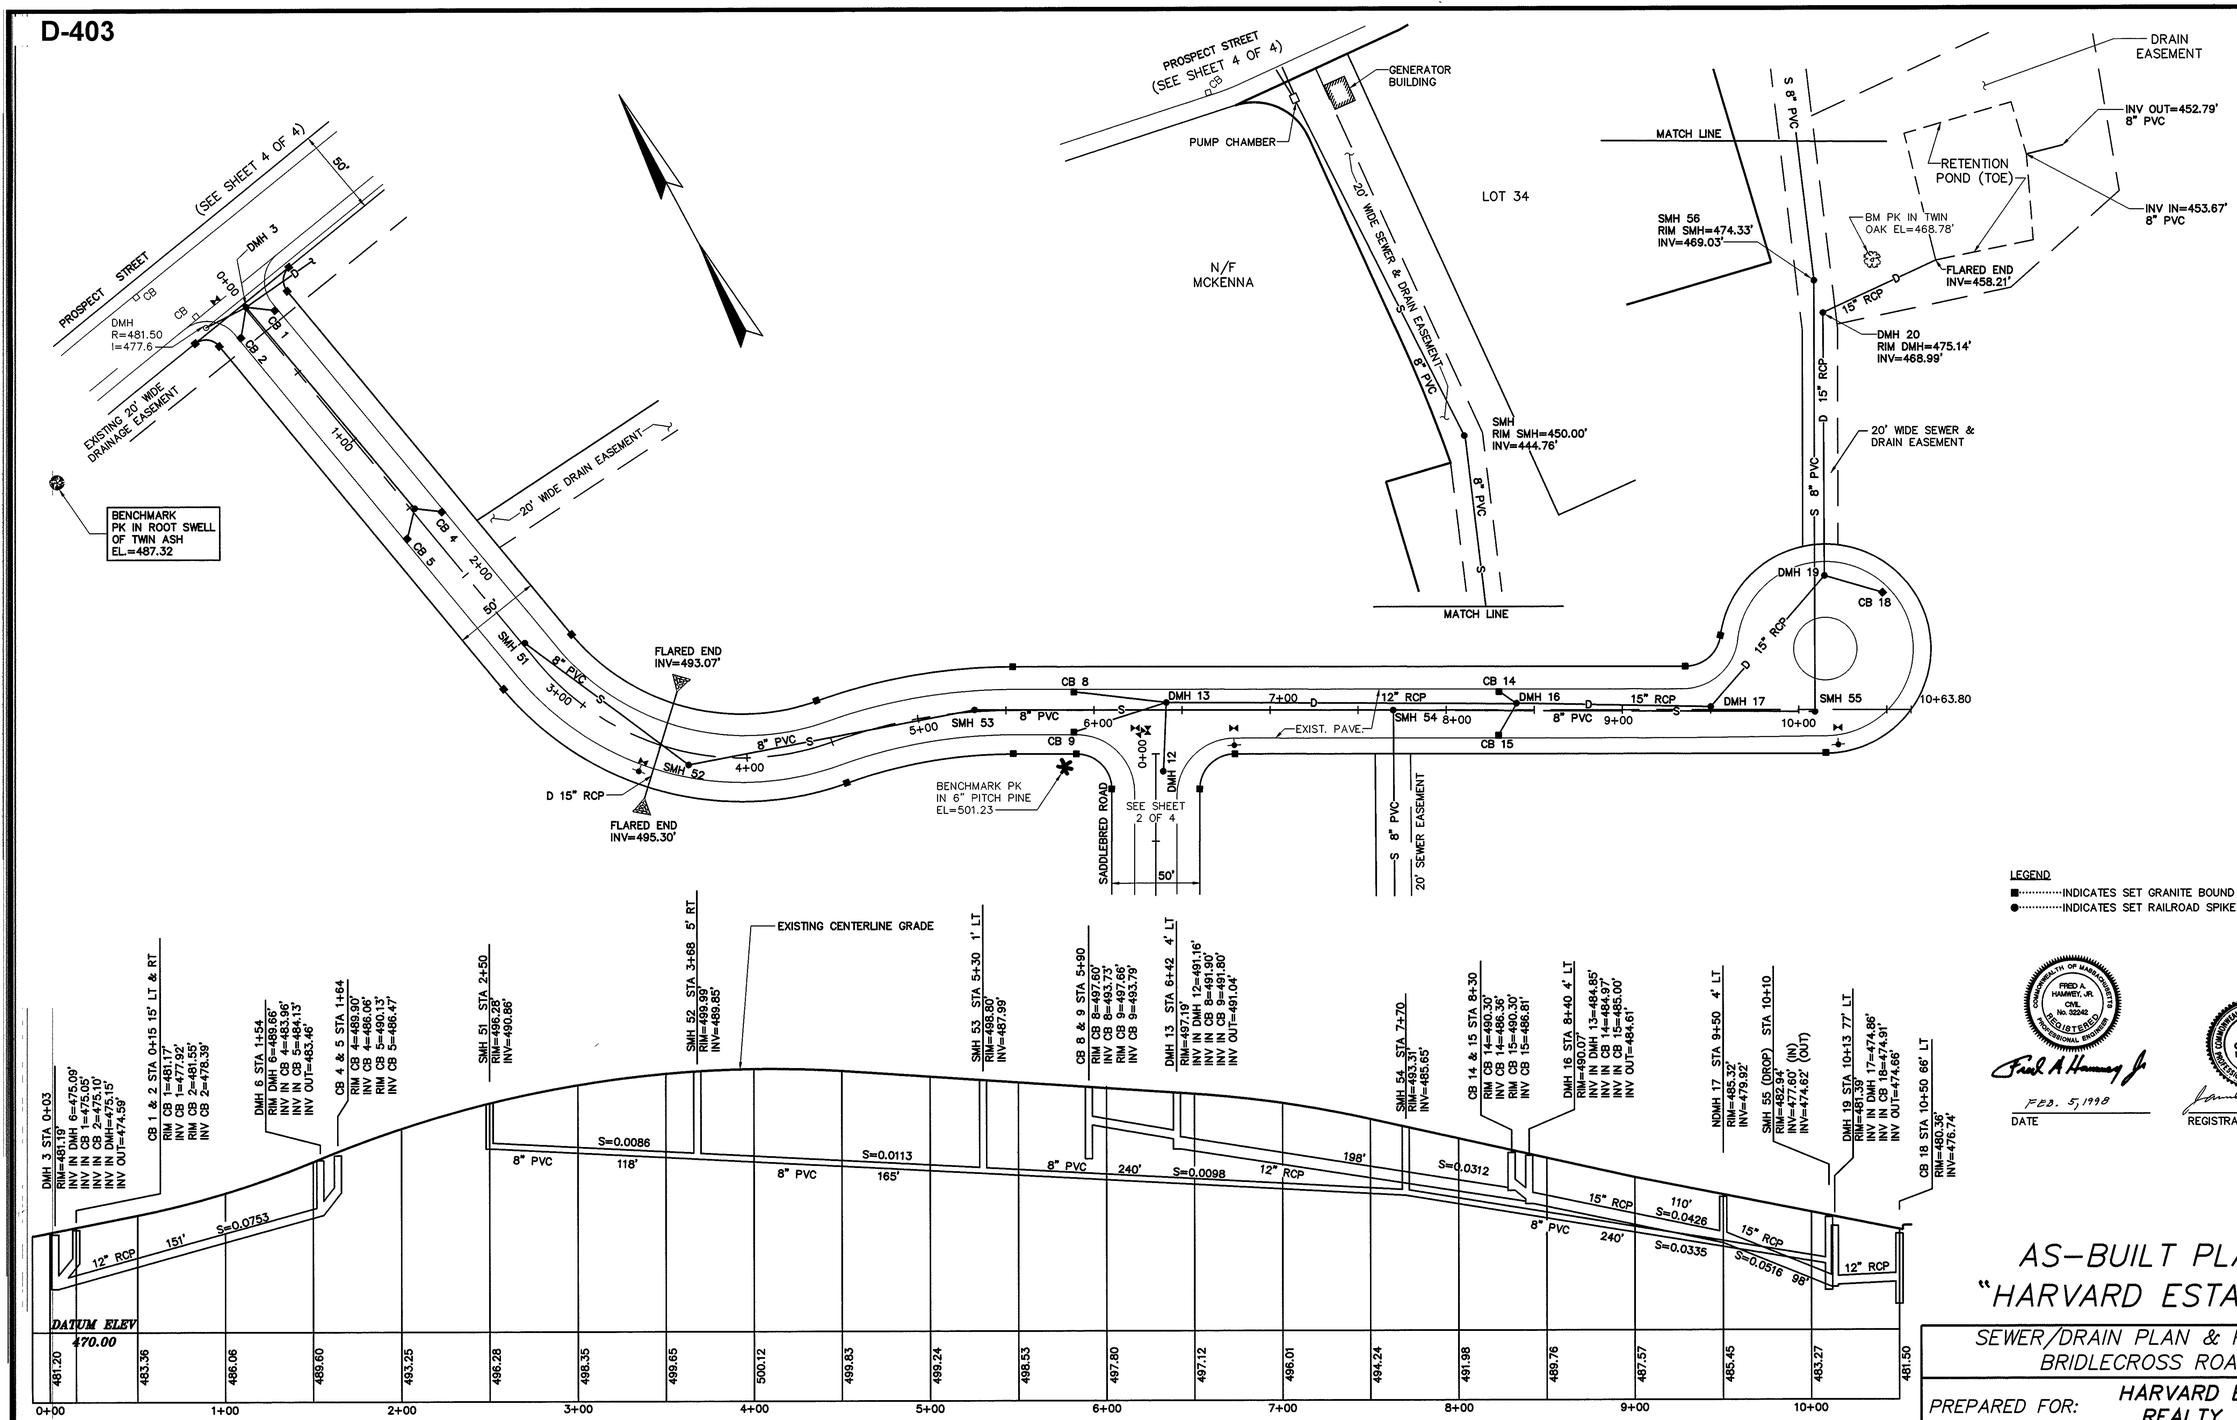

LEGEND

■ INDICATES SET GRANITE BOUND

● INDICATES SET RAILROAD SPIKE

COMMONWEALTH OF MASSACHUSETTS FRED A. HAMWEY, JR. CIVIL No. 32242 REGISTERED PROFESSIONAL ENGINEER

FEB. 5, 1998

DATE

COMMONWEALTH OF MASSACHUSETTS JAMES E. GAFFNEY No. 29866 REGISTERED PROFESSIONAL LAND SURVEYOR

REGISTRATION NO. 29866

AS-BUILT PLAN "HARVARD ESTATES"

SEWER/DRAIN PLAN & PROFILE
BRIDLECROSS ROAD

PREPARED FOR: HARVARD ESTATES REALTY TRUST

DATE	SCALE	SHEET NO.
JANUARY, 1998	HOR. 1"=40', VERT. 1"=8'	1 OF 4

SURVEYOR: PL. NO. 805-E
JAMES E. GAFFNEY CO.
55 ST. JEAN AVENUE
LEOMINSTER, MA 01453
(978) 534-3443

D-403