D-404

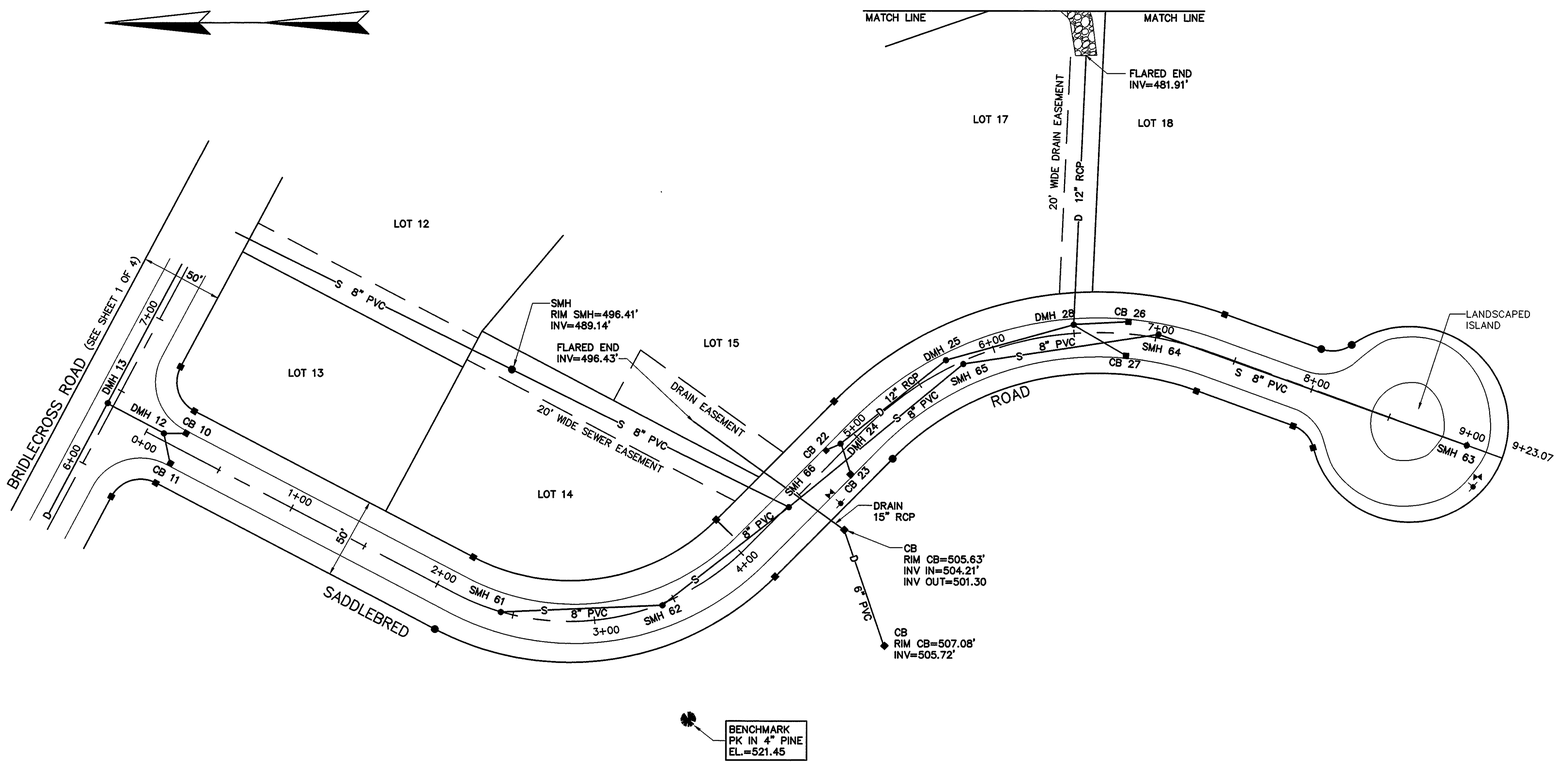

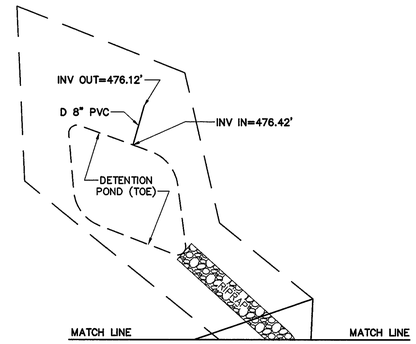

LEGEND
■.....INDICATES SET GRANITE BOUND
●.....INDICATES SET RAILROAD SPIKE

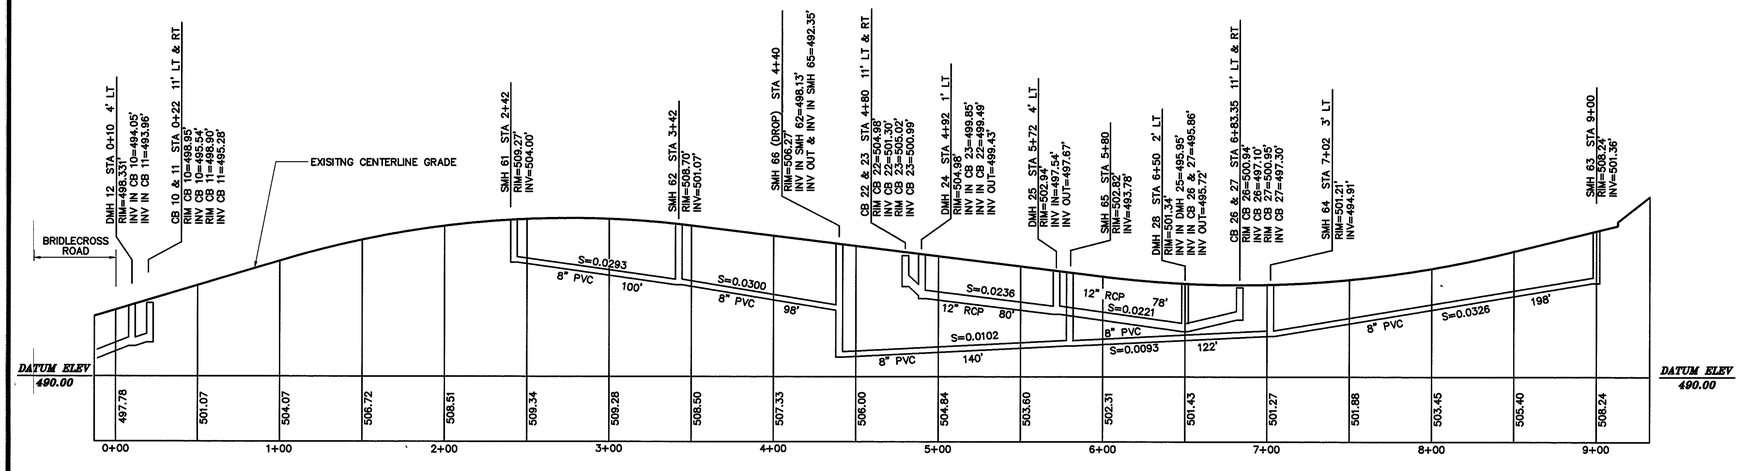

COMMONWEALTH OF MASSACHUSETTS
FRED A. HAWKEY, JR.
CIVIL
No. 32242
REGISTERED
PROFESSIONAL ENGINEER

Fred A. Hawkey Jr.
FEB. 5, 1998
DATE

COMMONWEALTH OF MASSACHUSETTS
JAMES E. GAFFNEY
No. 29866
REGISTERED
PROFESSIONAL LAND SURVEYOR

REGISTRATION NO. 29866

AS-BUILT PLAN
"HARVARD ESTATES"

SEWER/DRAIN PLAN & PROFILE
SADDLEBRED ROAD

PREPARED FOR: HARVARD ESTATES REALTY TRUST

DATE	SCALE	SHEET NO.
JANUARY, 1998	HOR. 1"=40', VERT. 1"=8'	2 OF 4

SURVEYOR: PL. NO. 805-E
JAMES E. GAFFNEY CO.
55 ST. JEAN AVENUE
LEOMINSTER, MA 01453
(978) 534-3443

D-404