D-406

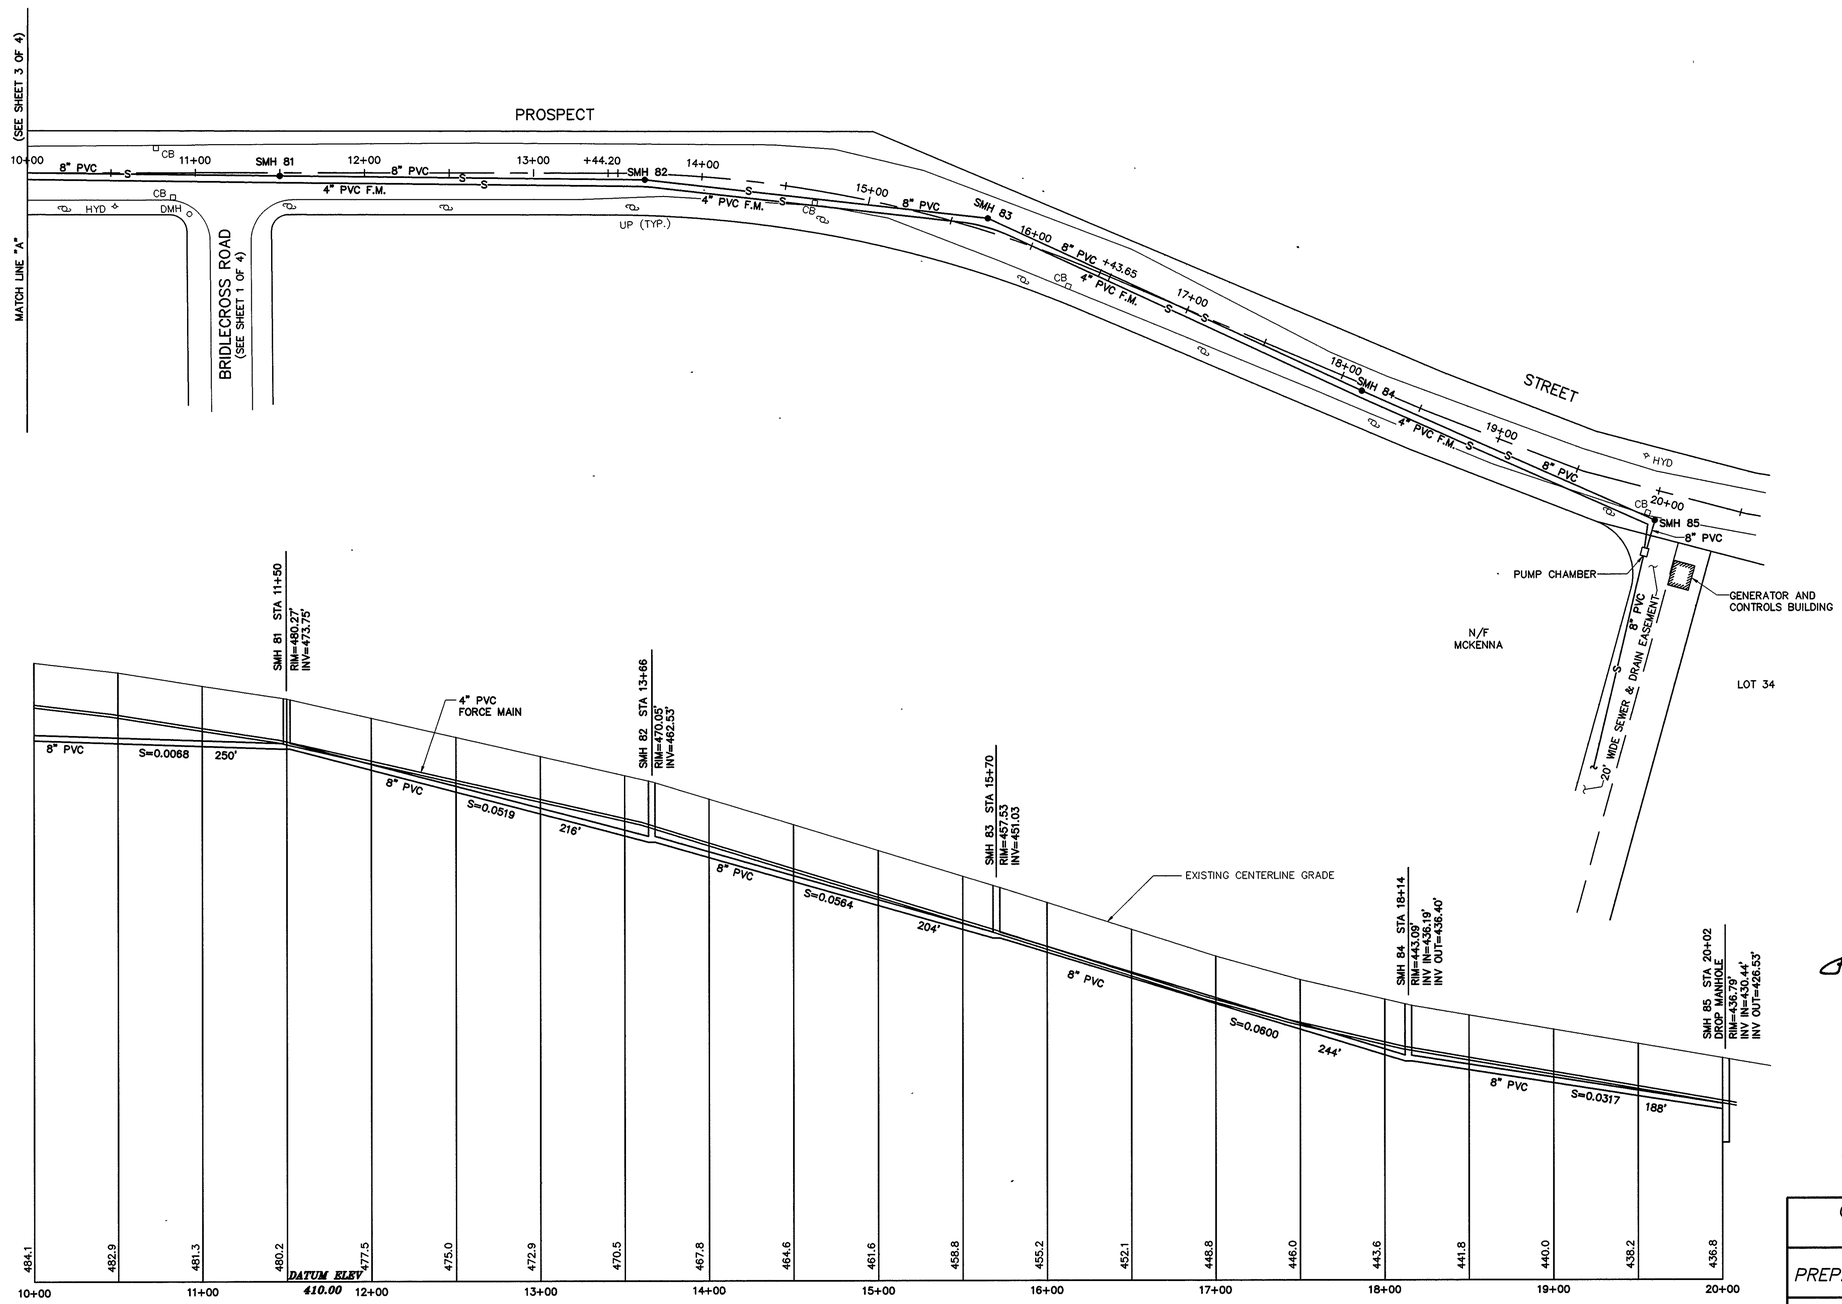

COMMONWEALTH OF MASSACHUSETTS FRED A. HAMMEY, JR. CIVIL No. 32242 REGISTERED PROFESSIONAL ENGINEER

Fred A. Hammey Jr

FEB. 5, 1998
DATE

COMMONWEALTH OF MASSACHUSETTS JAMES F. GAFFNEY No. 29866 REGISTERED PROFESSIONAL LAND SURVEYOR

James F. Gaffney P.L.S.
REGISTRATION NO. 29866

AS-BUILT PLAN
"HARVARD ESTATES"

GRAVITY SEWER & FORCE MAIN
PROSPECT STREET

PREPARED FOR: HARVARD ESTATES REALTY TRUST

DATE	SCALE	SHEET NO.
JANUARY, 1998	HOR. 1"=40', VERT. 1"=8'	4 OF 4

SURVEYOR: PL. NO. 805-E
JAMES E. GAFFNEY CO.
55 ST. JEAN AVENUE
LEOMINSTER, MA 01453
(978) 534-3443

D-406