D-407

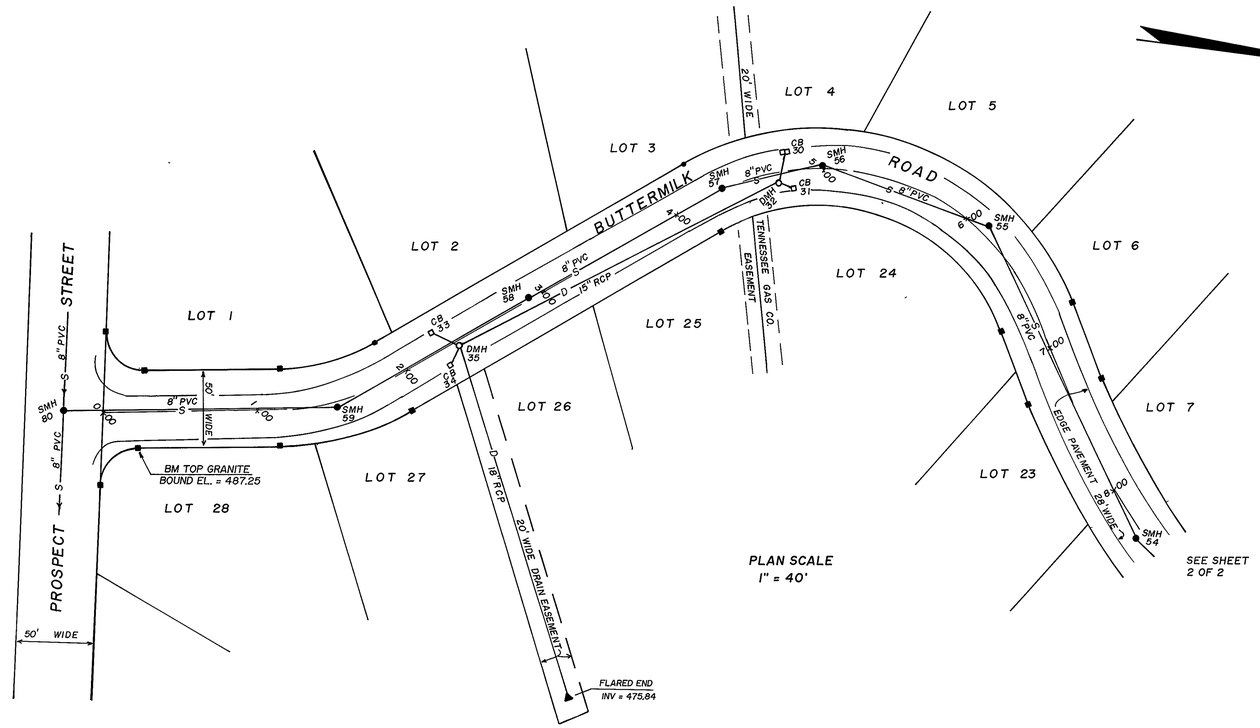

■ .... INDICATES SET GRANITE BOUND

● .... INDICATES SET RAILROAD SPIKE

VERTICAL ELEVATIONS ARE BASED UPON THE CITY OF LEOMINSTER DATUM.

NOTE: ALL CATCHBASIN TO DRAIN MANHOLE PIPES ARE 12" RCP.

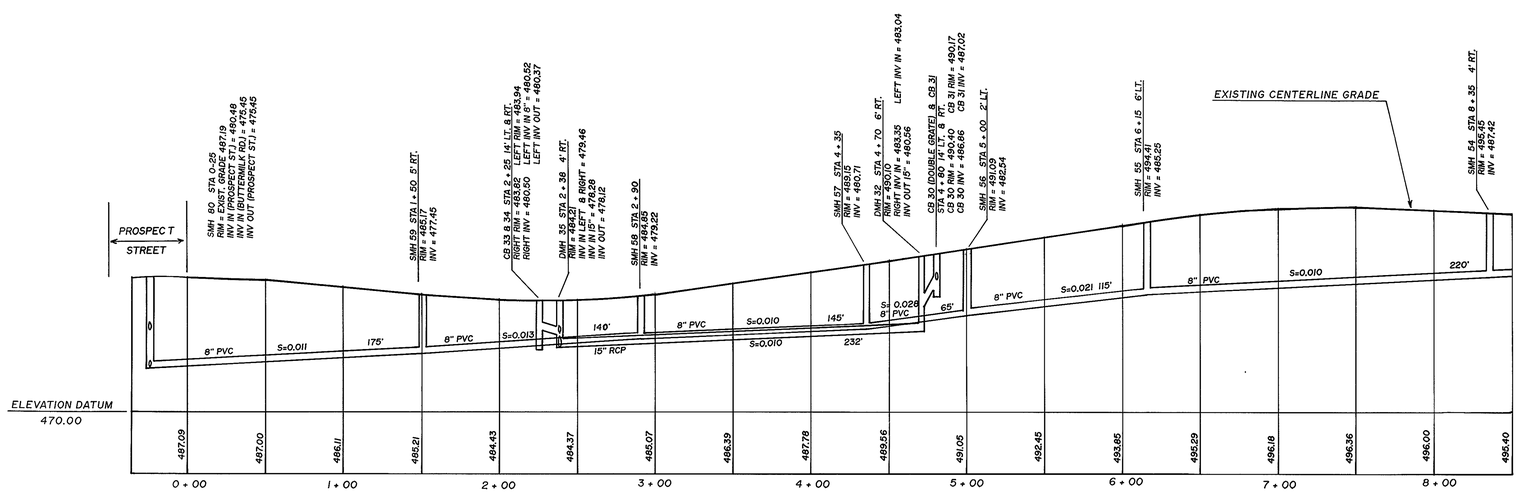

PROFILE SCALE
HORZ. 1" = 40'
VERT. 1" = 8'

FEB. 25, 1998
DATE

REGISTRATION NO. 29866

"CRESCENT FARMS"

AS-BUILT SEWER AND DRAIN PLAN & PROFILE
BUTTERMILK ROAD
LEOMINSTER, MA
PREPARED FOR
HARVARD ESTATES REALTY TRUST

DATE	SCALE	JOB NO.	PLAN NO.
FEB. 1998	1" = 40'	92352	1050-C SHEET 1 OF 2

JAMES E. GAFFNEY CO.
PROFESSIONAL LAND SURVEYOR
55 ST. JEAN AVENUE LEOMINSTER, MA 01453
978 - 534 - 3443

D-407