D-408

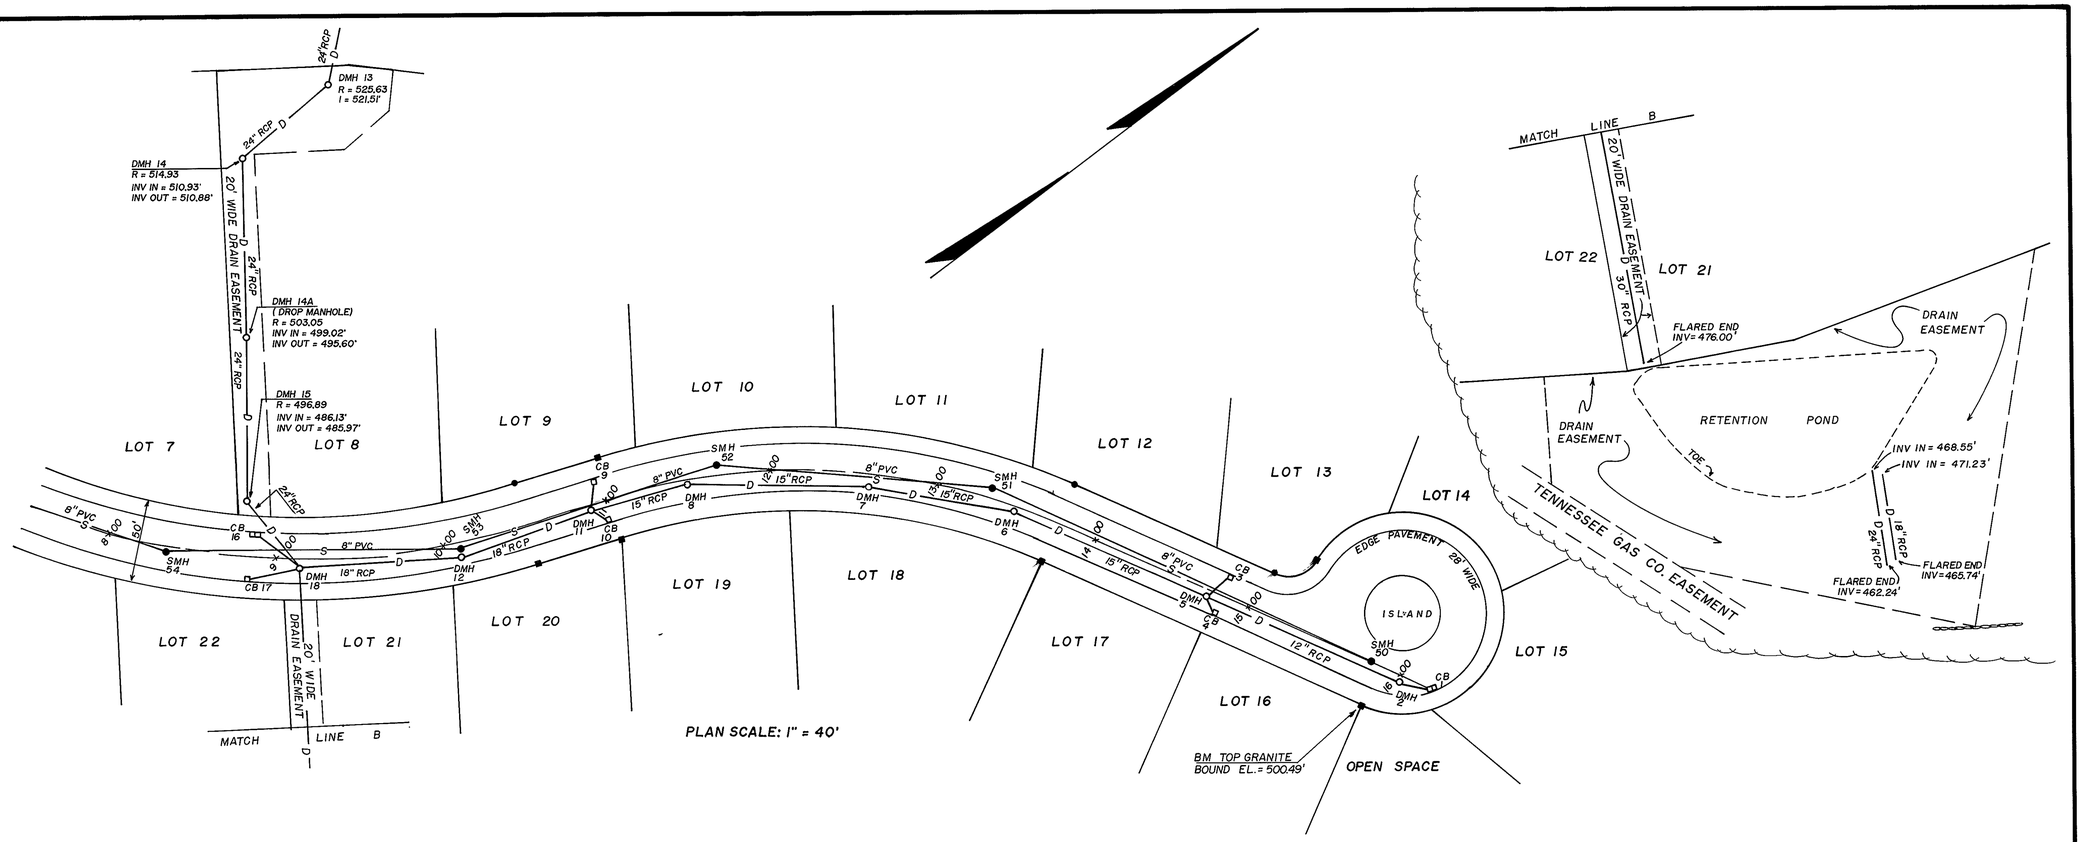

■ ..... INDICATES SET GRANITE BOUND

● ..... INDICATES SET RAILROAD SPIKE

VERTICAL ELEVATIONS ARE BASED UPON THE CITY OF LEOMINSTER DATUM.

NOTE: ALL CATCH BASIN TO DRAIN MANHOLE PIPES ARE 12" RCP.

COMMONWEALTH OF MASSACHUSETTS
FRED A. HAMMET, JR.
CIVIL
No. 32242
REGISTERED
PROFESSIONAL ENGINEER

Fred A Hammet Jr

COMMONWEALTH OF MASSACHUSETTS
JAMES E. GAFFNEY
No. 29866
REGISTERED
PROFESSIONAL LAND SURVEYOR

James E. Gaffney PLS

FEB. 25, 1998
DATE

REGISTRATION NO. 29866

"CRESCENT FARMS"

AS-BUILT SEWER AND DRAIN PLAN & PROFILE

BUTTERMILK ROAD
LEOMINSTER, MA

PREPARED FOR

HARVARD ESTATES REALTY TRUST

DATE	SCALE	JOB NO.	PLAN NO.
FEB. 1998	1" = 40'	92352	1050-C SHEET 2 OF 2

JAMES E. GAFFNEY CO.
PROFESSIONAL LAND SURVEYOR
55 ST. JEAN AVENUE LEOMINSTER, MA 01453
978 - 534 - 3443

D-408