D-409

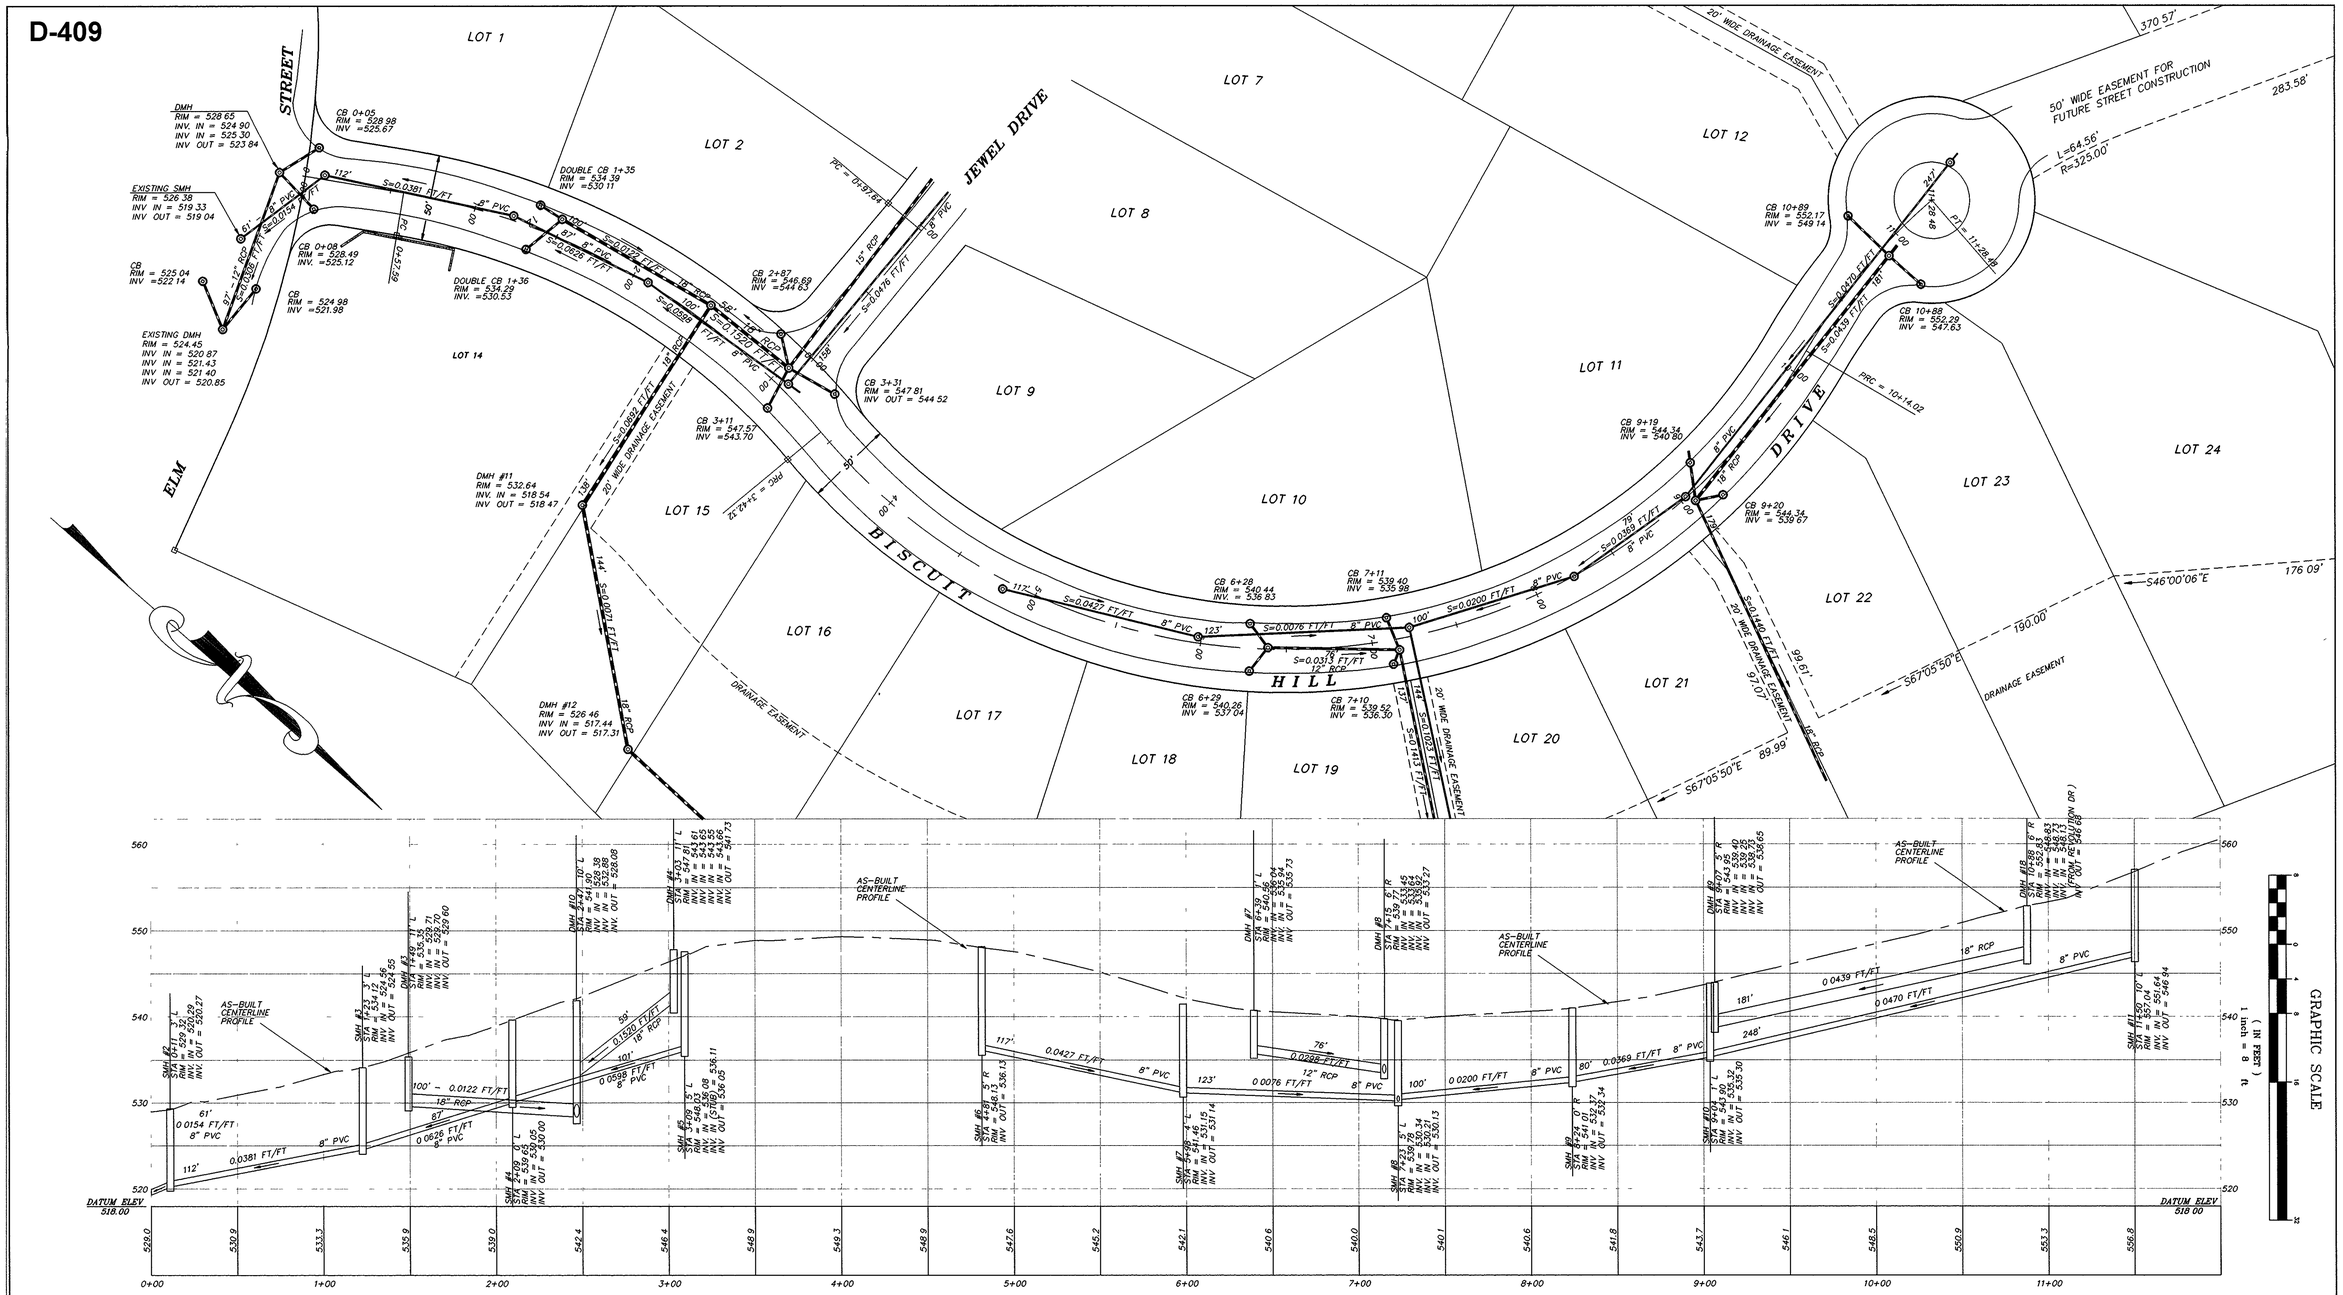

LEGEND

- SANITARY SEWER
- STORM DRAIN
- MANHOLE
- CATCH BASIN

ELEVATIONS BASED ON CITY OF LEOMINSTER DATUM

GRAPHIC SCALE

(IN FEET)
1 inch = 40 ft

SEWER PLAN & PROFILE

COMMONWEALTH OF MASSACHUSETTS
WILLIAM D. HANNIGAN
CIVIL
38439
REGISTERED PROFESSIONAL ENGINEER
12-16-97

BISCUIT HILL DRIVE AS-BUILT IN LEOMINSTER, MASSACHUSETTS

PREPARED FOR: SECURED FINANCIAL LIMITED PARTNERSHIP LEOMINSTER, MA 01453 TEL:	CALC: JRR	DRWN: JRR
	CHKD: WDH	SCALE: AS SHOWN
	APPD: JMO	DATE: DEC 8, 1997
DWG: BOV-BSCT	HANNIGAN ENGINEERING CIVIL ENGINEERS & LAND SURVEYORS 14 MONUMENT SQUARE SUITE 301 LEOMINSTER, MASSACHUSETTS 01453 (508) 534-1234 FAX (508) 534-6060	JOB NO: 1127
SRV: GRJ		SHEET 3 OF 6
FB: 13-155		PLAN NO: B-1-1

D-409