D-411

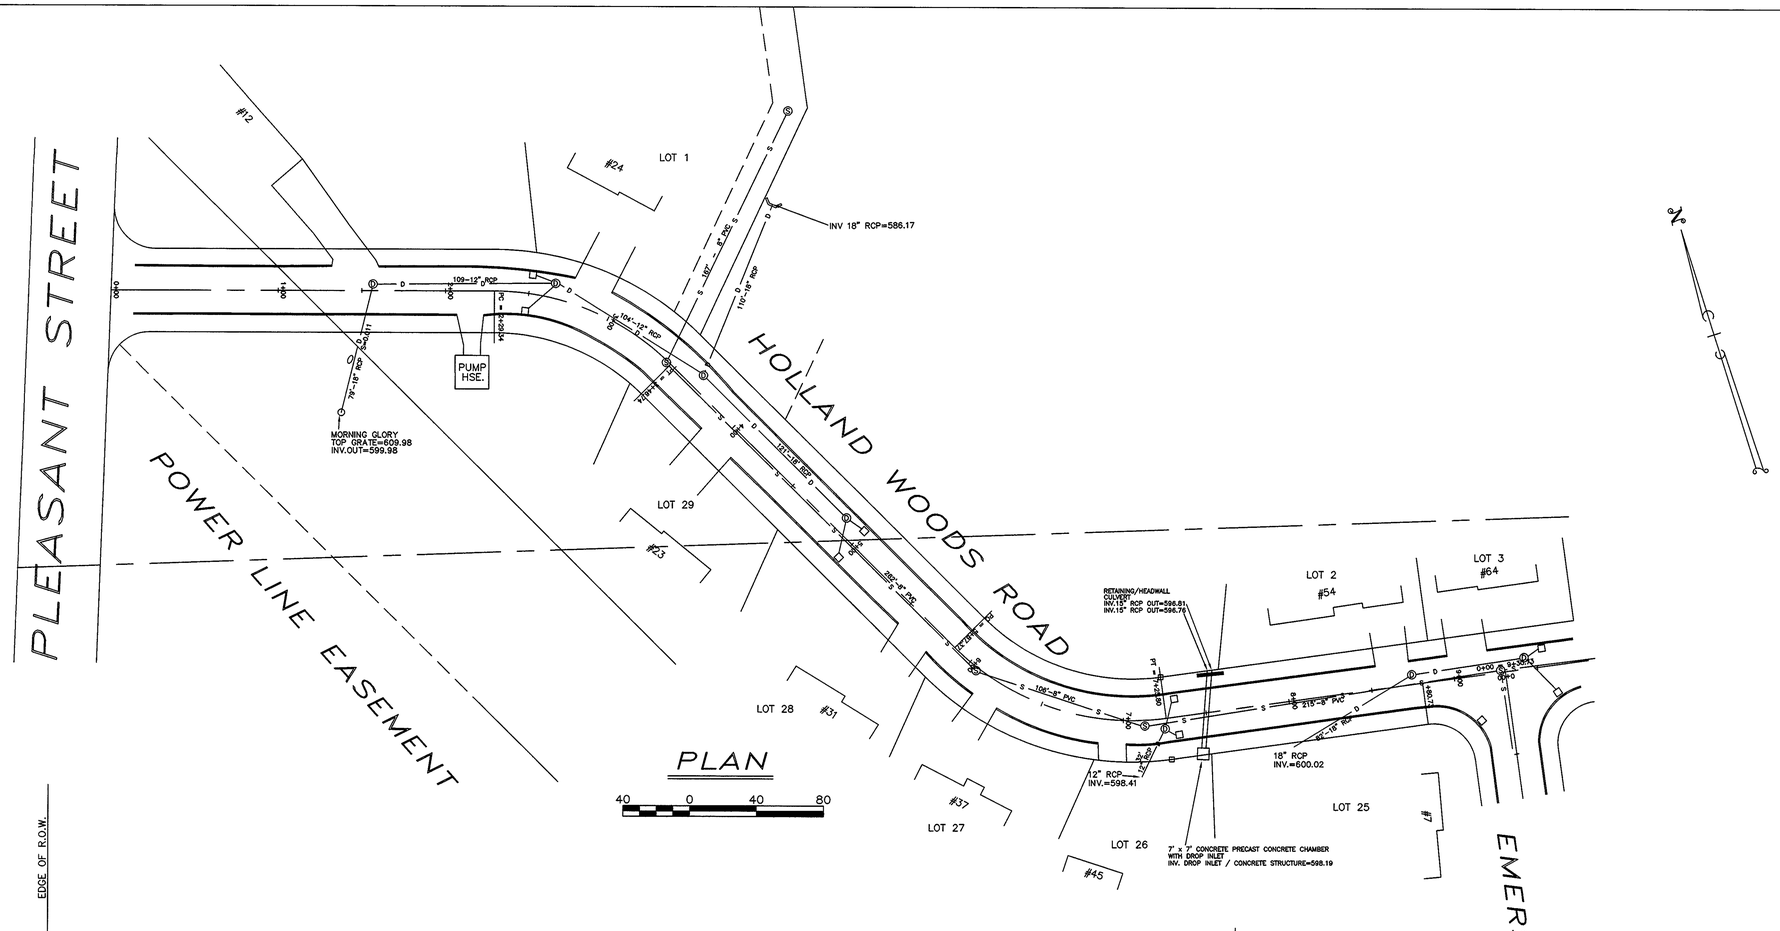

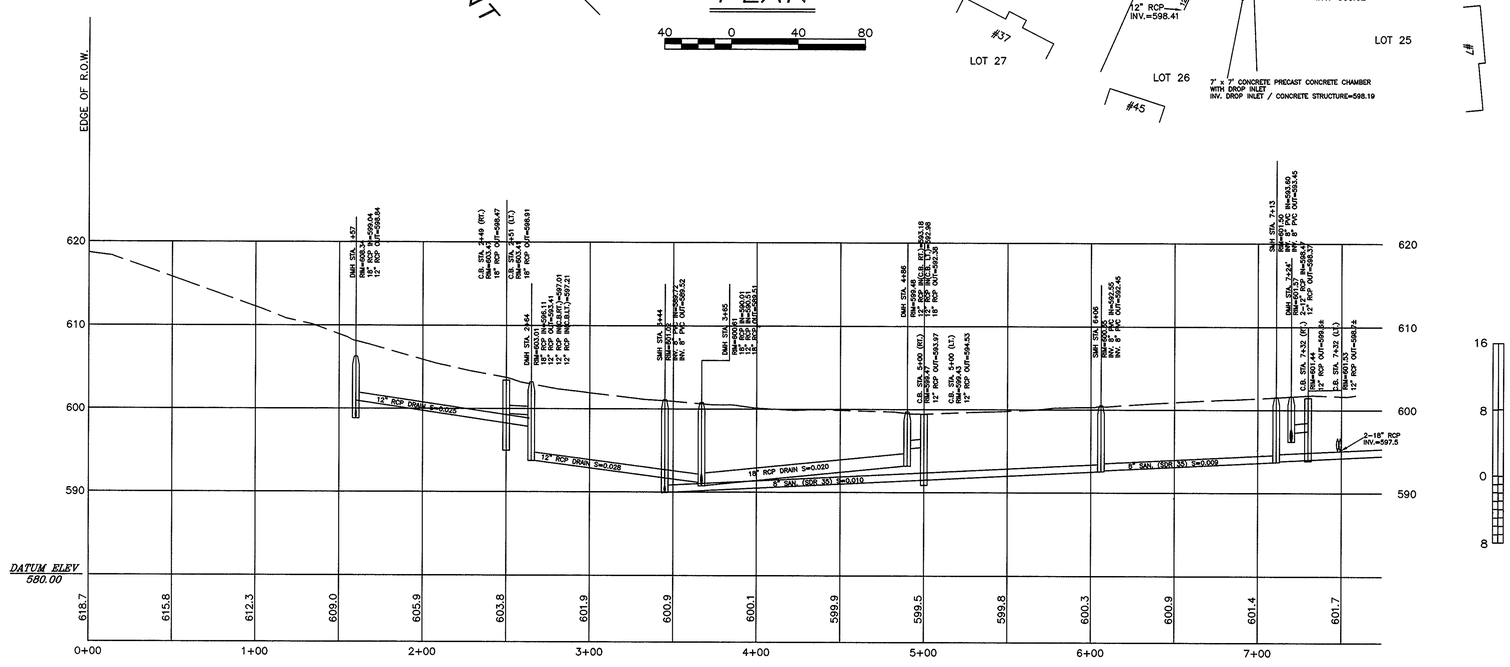

PROFILE

SCALE: HORIZ. 1"=40' VERT. 1"=8'

HOLLAND WOODS

AS-BUILT SEWER PLAN & PROFILE

IN LEOMINSTER, MASS.

PREPARED FOR

CARTER HILL CAPITAL CORP.

MARCH 13, 1998

40 0 40 80

WHITMAN & BINGHAM ASSOCIATES, INC.
REGISTERED PROFESSIONAL ENGINEERS & LAND SURVEYORS
510 MECHANIC STREET – LEOMINSTER, MASSACHUSETTS 01453

SHEET 1 OF 2

D-411