D-411a

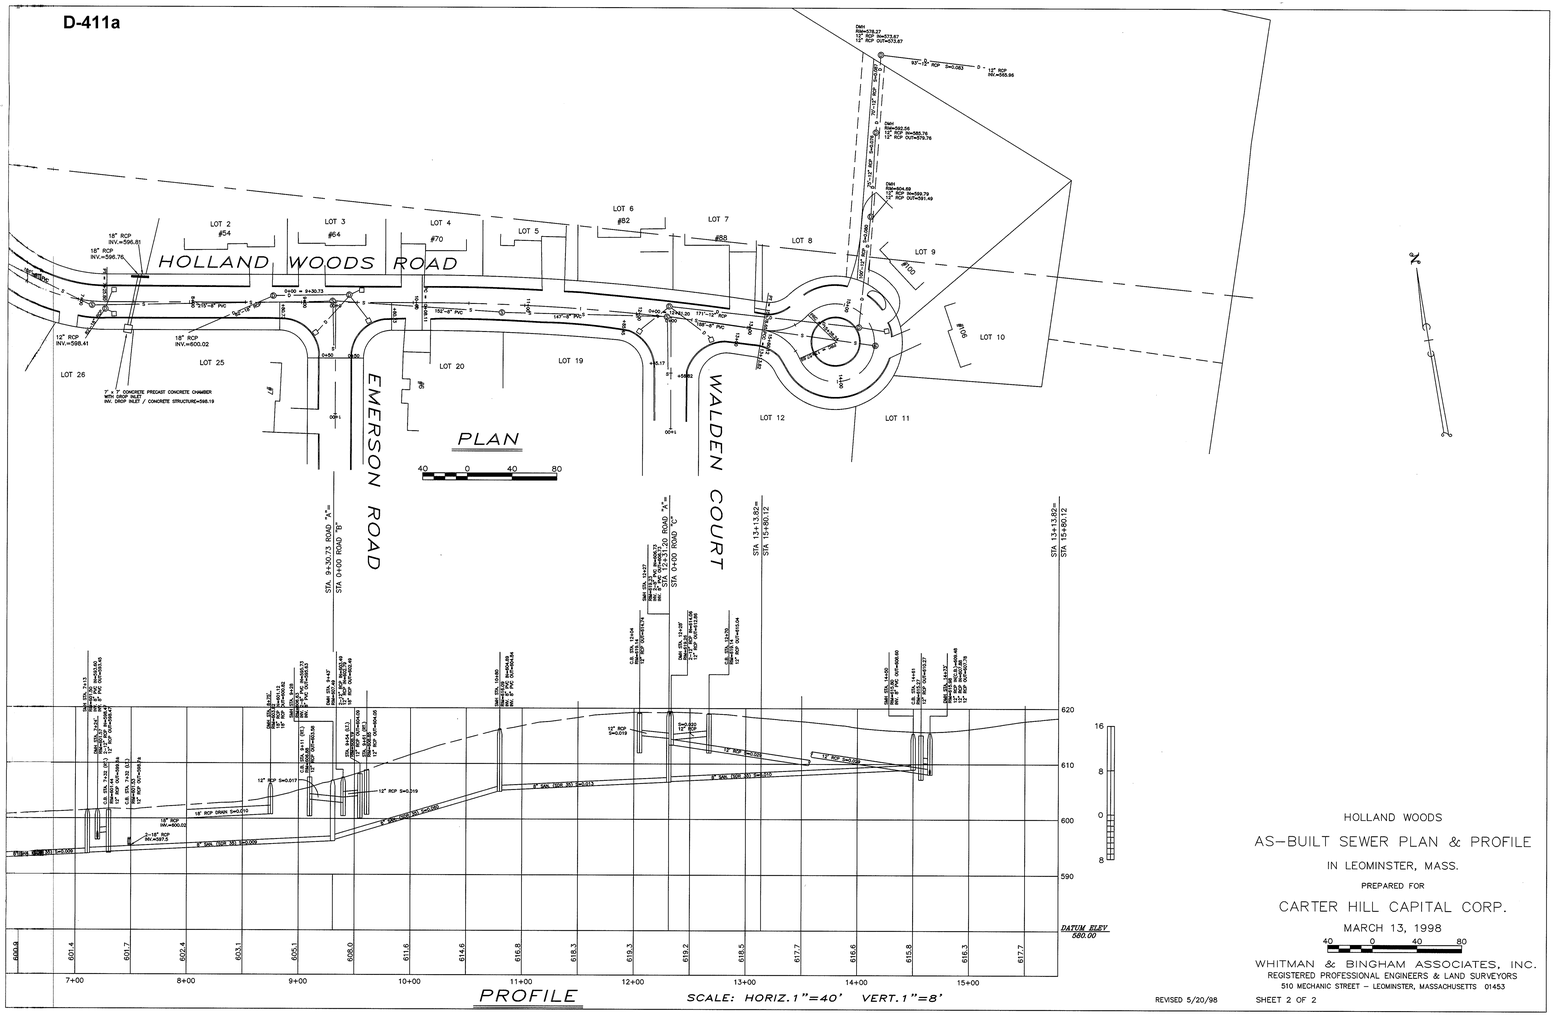

HOLLAND WOODS

AS-BUILT SEWER PLAN & PROFILE

IN LEOMINSTER, MASS.

PREPARED FOR

CARTER HILL CAPITAL CORP.

MARCH 13, 1998

WHITMAN & BINGHAM ASSOCIATES, INC.
REGISTERED PROFESSIONAL ENGINEERS & LAND SURVEYORS
510 MECHANIC STREET – LEOMINSTER, MASSACHUSETTS 01453

REVISED 5/20/98

SHEET 2 OF 2

D-411A