D-413a

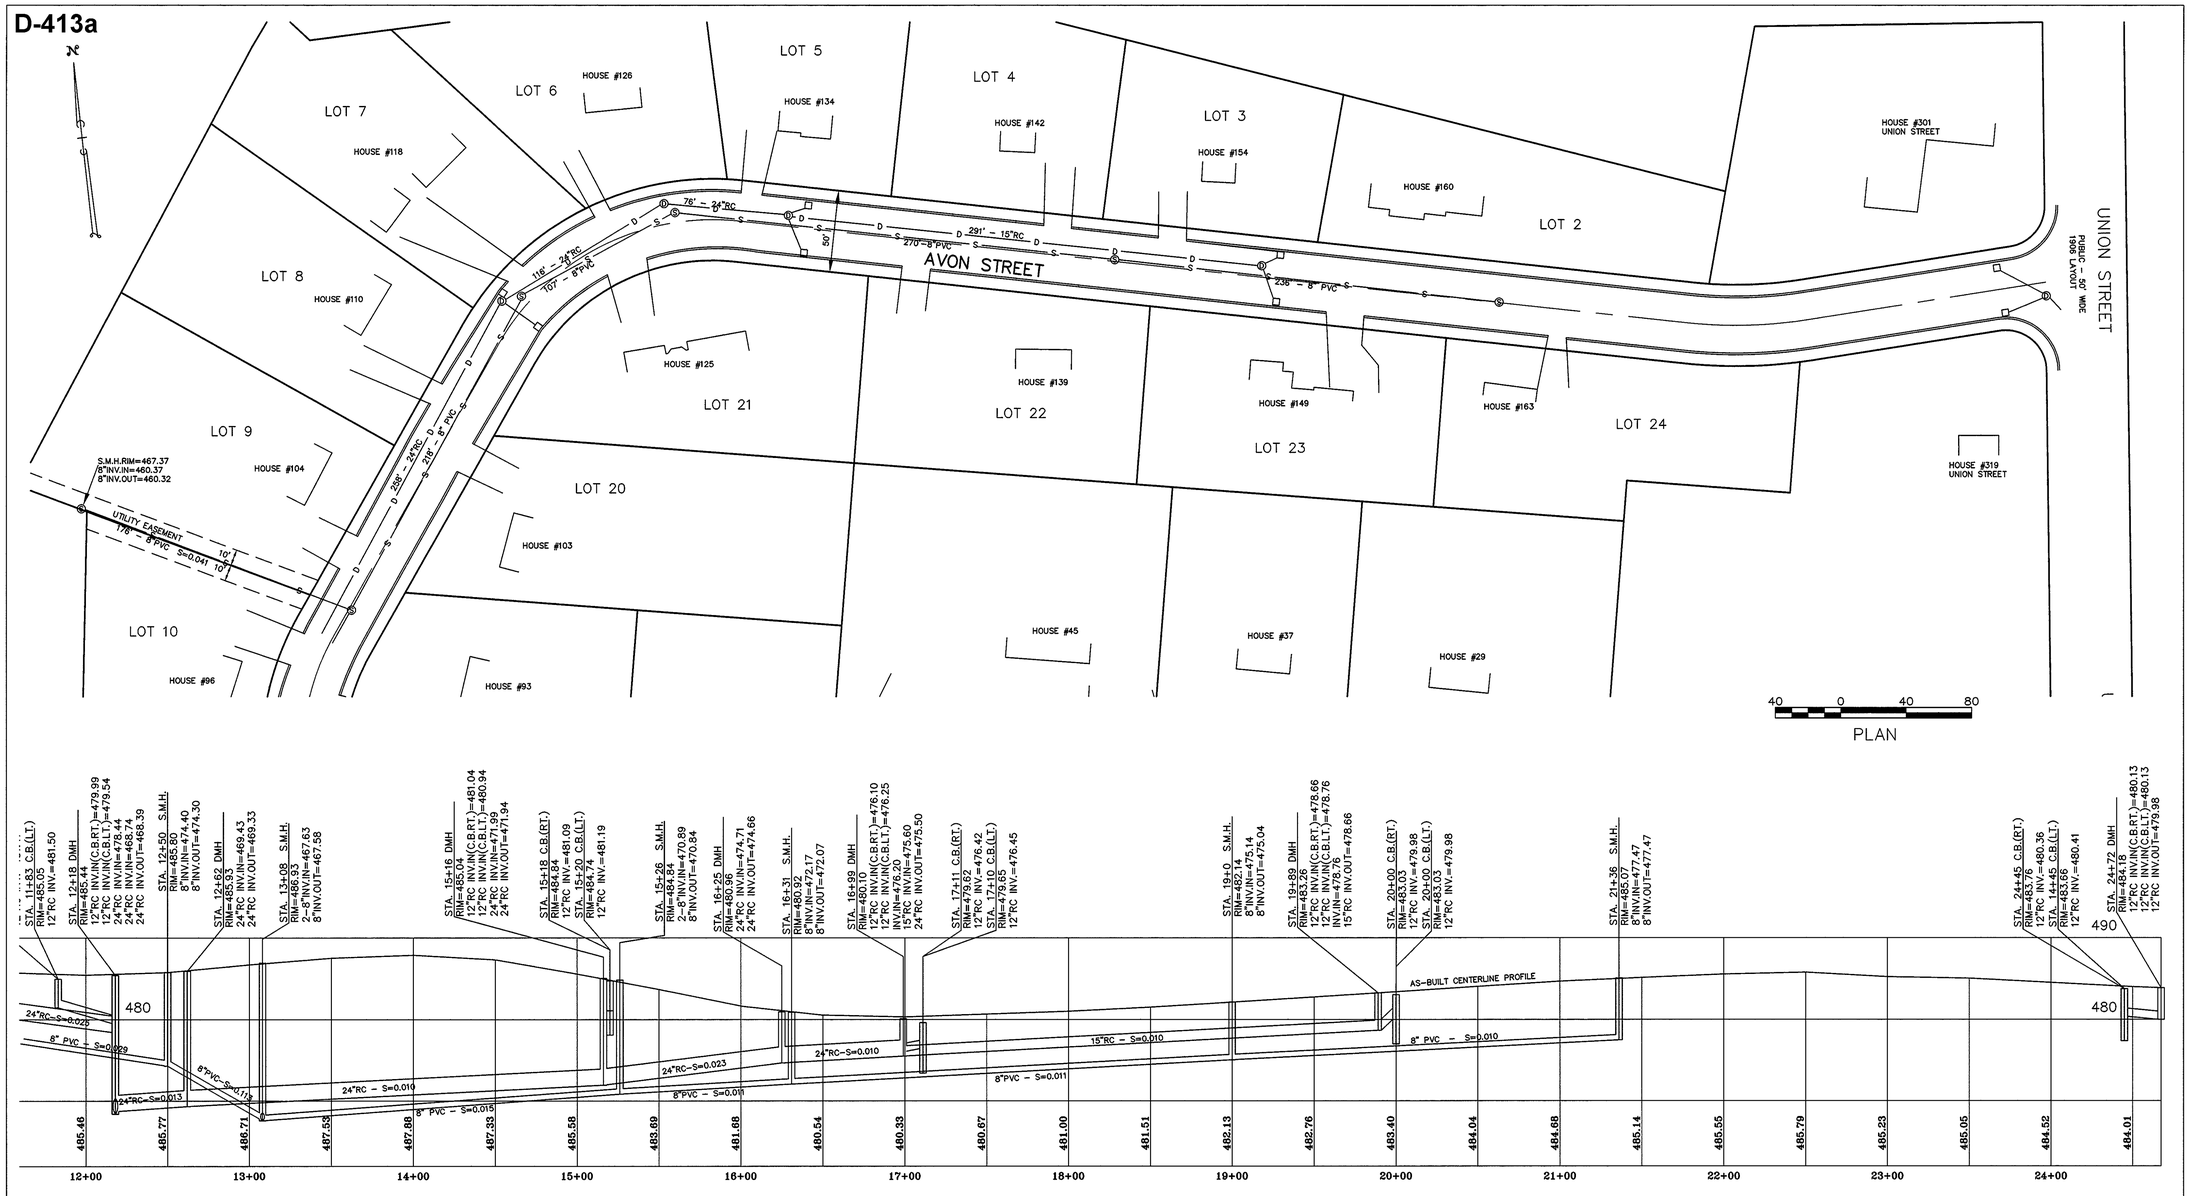

PROFILE

16
8
0
8

LEGEND

- SEWER MANHOLE
- DRAIN MANHOLE
- CATCH BASIN
- ASPHALT BERM
- EDGE OF PAVEMENT

HEATHER HILL ESTATES

LEOMINSTER, MASS.

AS-BUILT SEWER PLAN & PROFILE

AVON STREET

APRIL 1998

SCALES AS SHOWN

WHITMAN & BINGHAM ASSOCIATES, INC.

REGISTERED PROFESSIONAL ENGINEERS & LAND SURVEYORS

510 MECHANIC STREET - LEOMINSTER, MASSACHUSETTS 01453

COMMONWEALTH OF MASSACHUSETTS
STEVEN J. WHITMAN
CIVIL
No. 30597
REGISTERED PROFESSIONAL ENGINEER

6/16/98

SHEET 2 OF 2 SHEETS

24-D-32

D-413A