D-413b

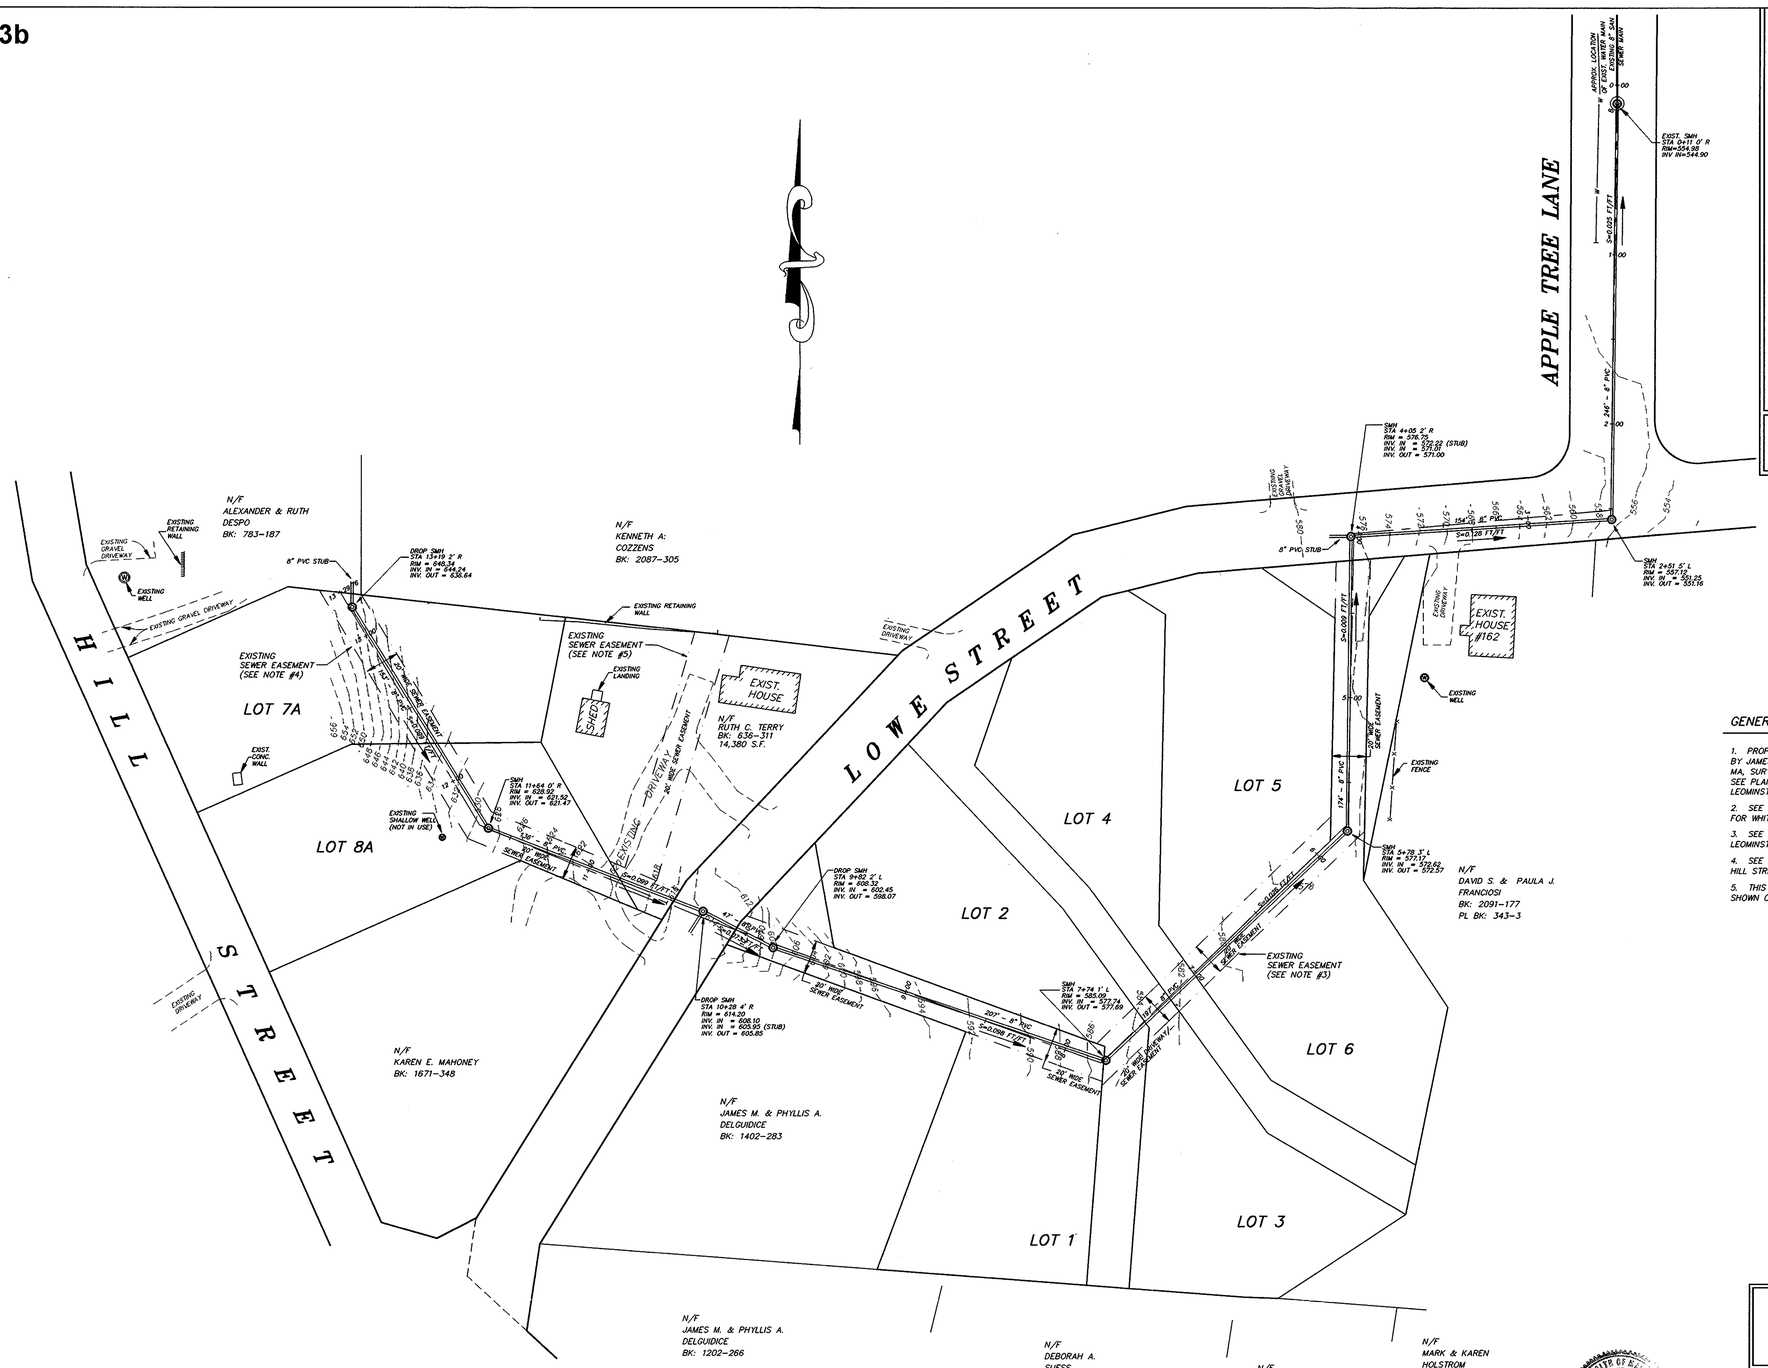

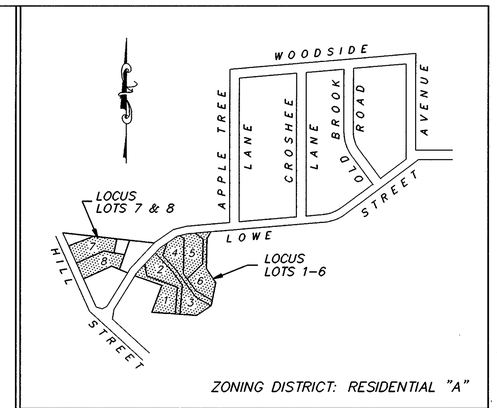

LOCUS MAP
NO SCALE

GENERAL NOTES:

1. PROPERTY LINE INFORMATION IS BASED ON AN ON-THE-GROUND SURVEY BY JAMES E. GAFFNEY COMPANY. SEE PLAN DATED JULY 1995 ENTITLED "LAND IN LEOMINSTER, MA, SURVEYED FOR WHITNEY CORPORATION" BY JAMES E. GAFFNEY CO. FOR LOTS 1 THROUGH 6. SEE PLAN DATED FEBRUARY 1996 (REVISED APRIL 9, 1996) ENTITLED "LAND IN LEOMINSTER, MA SURVEYED FOR WHITNEY CORPORATION" BY JAMES E. GAFFNEY CO. FOR LOTS 7A AND 8A.
2. SEE PLAN DATED MARCH 1996 ENTITLED "EASEMENT PLAN, LAND IN LEOMINSTER, MA SURVEYED FOR WHITNEY CORPORATION" BY JAMES E. GAFFNEY CO. COVERING LOTS 1 THROUGH 6.
3. SEE PLAN DATED FEBRUARY 1996 (REVISED APRIL 9, 1996) ENTITLED "EASEMENT PLAN, LAND IN LEOMINSTER, MA SURVEYED FOR WHITNEY CORPORATION" BY JAMES E. GAFFNEY CO. COVERING LOTS 7A AND 8A.
4. SEE PLAN DATED SEPT.24, 1996 ENTITLED "EASEMENT PLAN IN LEOMINSTER, MA PREPARED FOR HILL STREET REALTY TRUST" BY HANNIGAN ENGINEERING.
5. THIS PLAN DEPICTS THE AS-BUILT SEWER. OTHER STRUCTURES AND UTILITIES MAY EXIST THAT ARE NOT SHOWN ON THIS PLAN.

COMMONWEALTH OF MASSACHUSETTS
WILLIAM D. HANNIGAN
CIVIL
No. 18458
PROFESSIONAL ENGINEER
9-12-97

AS-BUILT SEWER PLAN IN LEOMINSTER, MASSACHUSETTS

PREPARED FOR: J. WHITNEY DEVELOPMENT, INC. JIM WHITNEY 50 OLD MILL ROAD LEOMINSTER, MASSACHUSETTS TEL: (978) 840-6848	CALC: JRR	DRWN: JRR
	CHKD: WDH	SCALE: 1"=40'
	APPD: WDH	DATE: SEP 12, 1997
DWG: JWD-SASB	HANNIGAN ENGINEERING CIVIL ENGINEERS & LAND SURVEYORS 8 MONUMENT SQUARE LEOMINSTER, MASSACHUSETTS 01453 (508) 534-1234 FAX (508) 534-6060	JOB NO: 1049
SRV: GRJ		SHEET 1 OF 2
FB: BK.:13,P.:68		PLAN NO: A-1-26

D-413b