D-413c

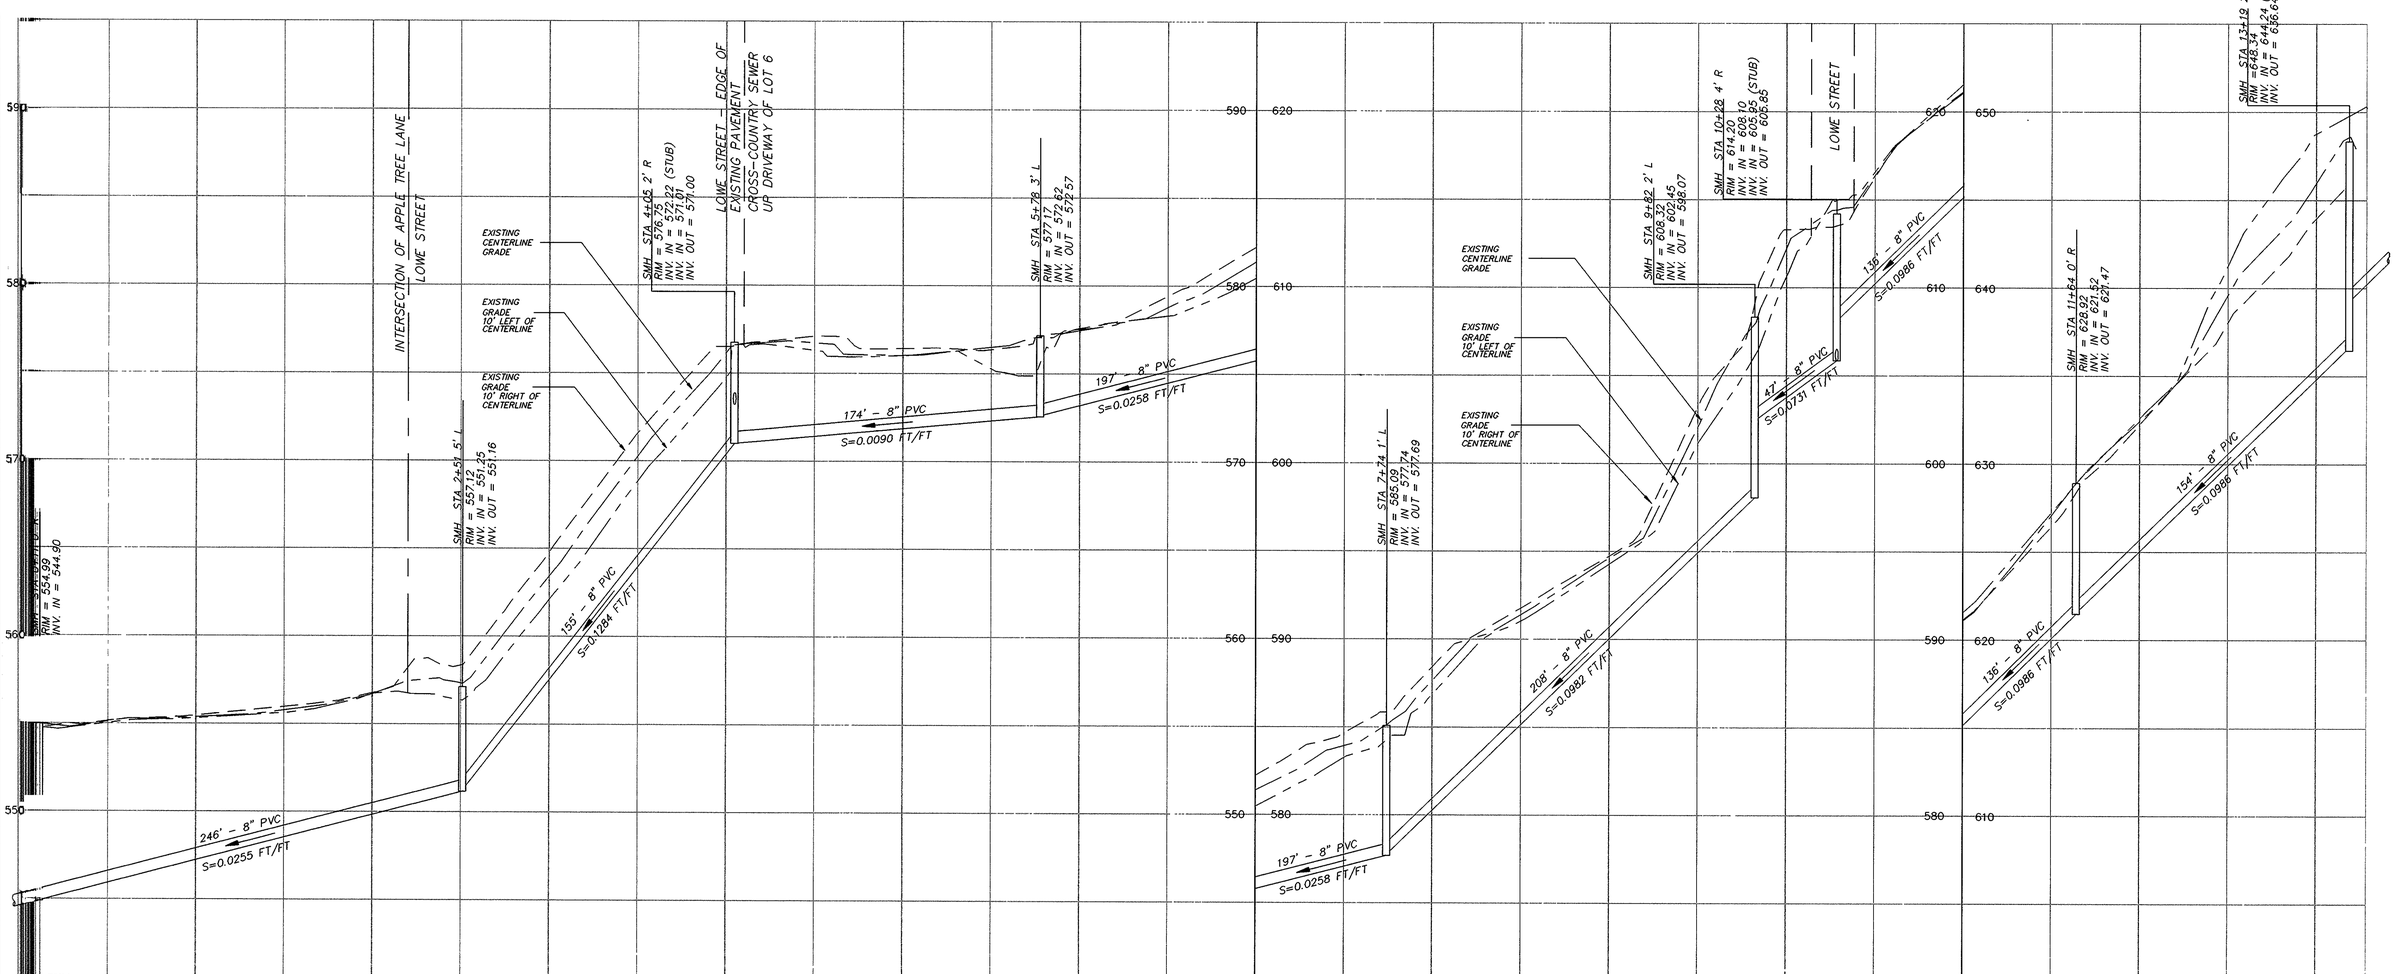

SEWER PROFILE

SCALE: HORIZONTAL: 1"=40'
VERTICAL: 1"=4'

WILLIAM D HANNIGAN CIVIL 32433 COMMONWEALTH OF MASSACHUSETTS PROFESSIONAL ENGINEER
9-12-97

AS-BUILT SEWER PROFILE
IN
LEOMINSTER, MASSACHUSETTS

PREPARED FOR: J. WHITNEY DEVELOPMENT, INC. JIM WHITNEY 50 OLD MILL ROAD LEOMINSTER, MASSACHUSETTS TEL: (978) 840-6848	CALC: JRR	DRWN: JRR
	CHKD: WDH	SCALE: 1"=40'
	APPD: WDH	DATE: SEP 12, 1997
DWG: JWD-SASB	HANNIGAN ENGINEERING CIVIL ENGINEERS & LAND SURVEYORS 8 MONUMENT SQUARE LEOMINSTER, MASSACHUSETTS 01453 (508) 534-1234 FAX (508) 534-6060	JOB NO: 1049
SRV: GRJ		SHEET 2 OF 2
FB: BK.:13,P.:68		PLAN NO: A-1-26

D-413C
D-413A