D-415b

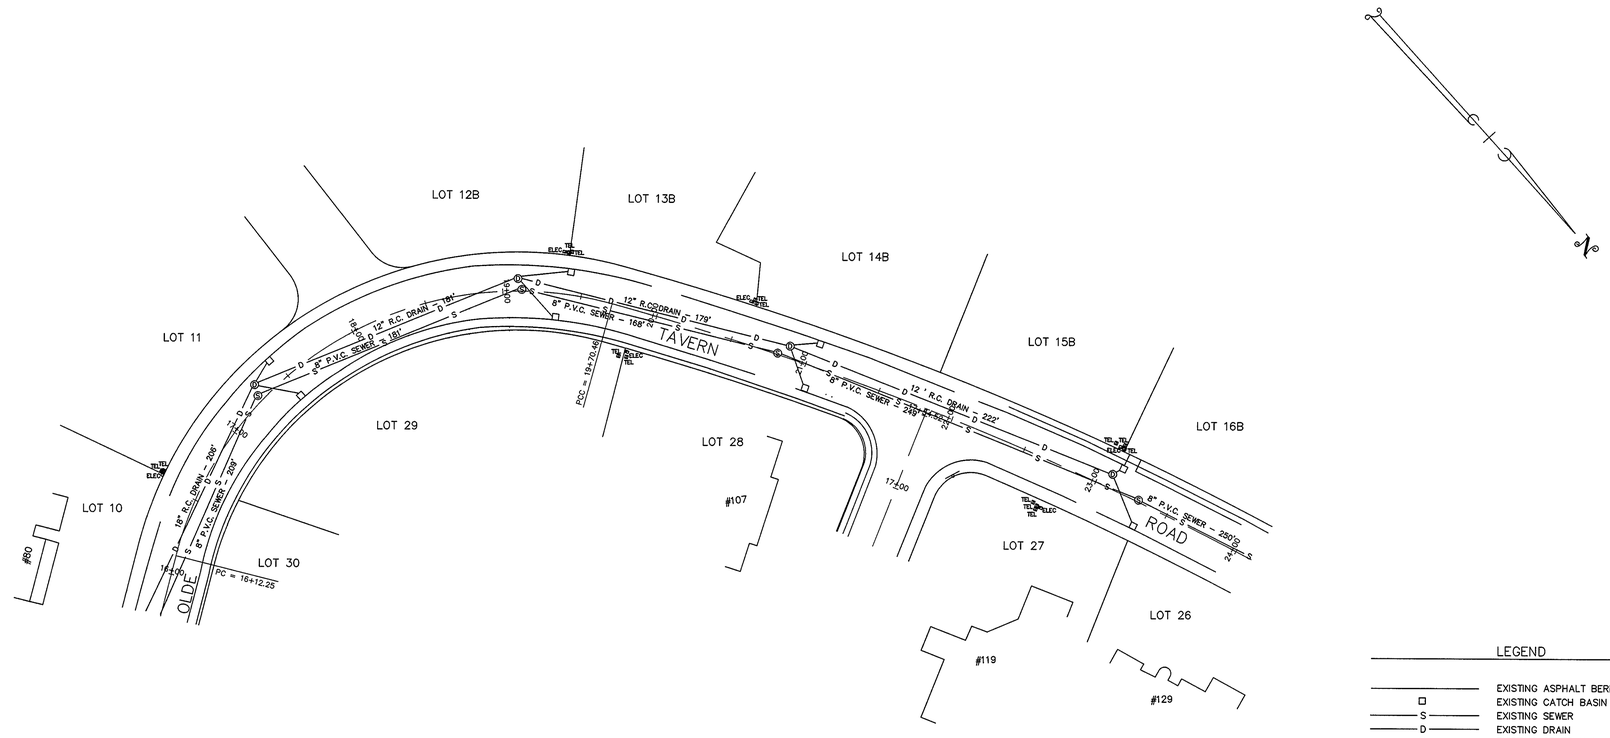

LEGEND

- EXISTING ASPHALT BERM
- EXISTING CATCH BASIN
- EXISTING SEWER
- EXISTING DRAIN
- EXISTING SEWER MANHOLE
- EXISTING DRAIN MANHOLE
- EXISTING HYDRANT
- EXISTING WATER GATE
- EXISTING WATER MAIN
- EXISTING ELECTRIC BOX
- EXISTING TELEPHONE BOX

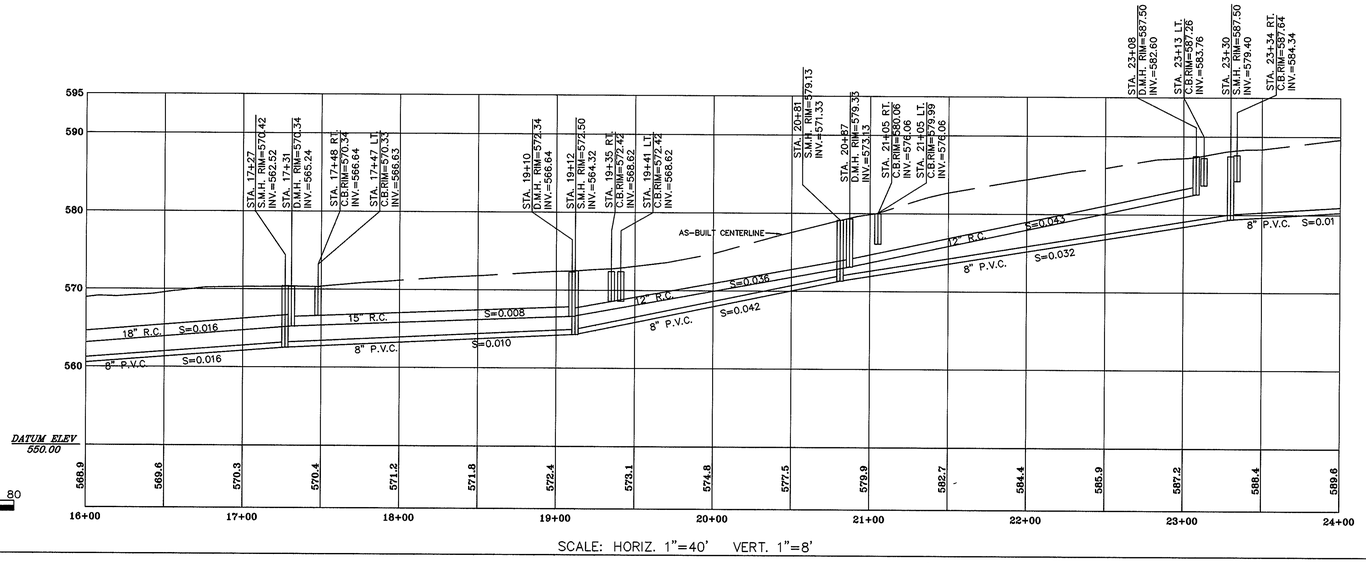

SCALE: HORIZ. 1"=40' VERT. 1"=8'

STEVEN J. WHITMAN
No. 34411
REGISTERED PROFESSIONAL ENGINEER
COMMONWEALTH OF MASSACHUSETTS
6/24/98

"KENDALL HILL ESTATES"

AS-BUILT SEWER PLAN AND PROFILE

LAND IN LEOMINSTER, MASS.

OLDE TAVERN ROAD

FEBRUARY 27, 1998

40 0 40 80

WHITMAN & BINGHAM ASSOCIATES, INC.
REGISTERED PROFESSIONAL ENGINEERS & LAND SURVEYORS
510 MECHANIC STREET - LEOMINSTER, MASSACHUSETTS 01453

SHEET 3 OF 4 17-D-29B