D-416




SEWER PROFILE

HORIZONTAL SCALE: 1" = 40'
VERTICAL SCALE: 1" = 4'

1. ELEVATIONS BASED UPON CITY OF LEOMINSTER SEWER BENCH.
2. UTILITIES SHOWN ON THIS PLAN ARE BASED UPON SEWER AND DRAINAGE STRUCTURES VISIBLE AT THE TIME OF THE SURVEY. OTHER UTILITIES MAY EXIST WHICH ARE NOT SHOWN.

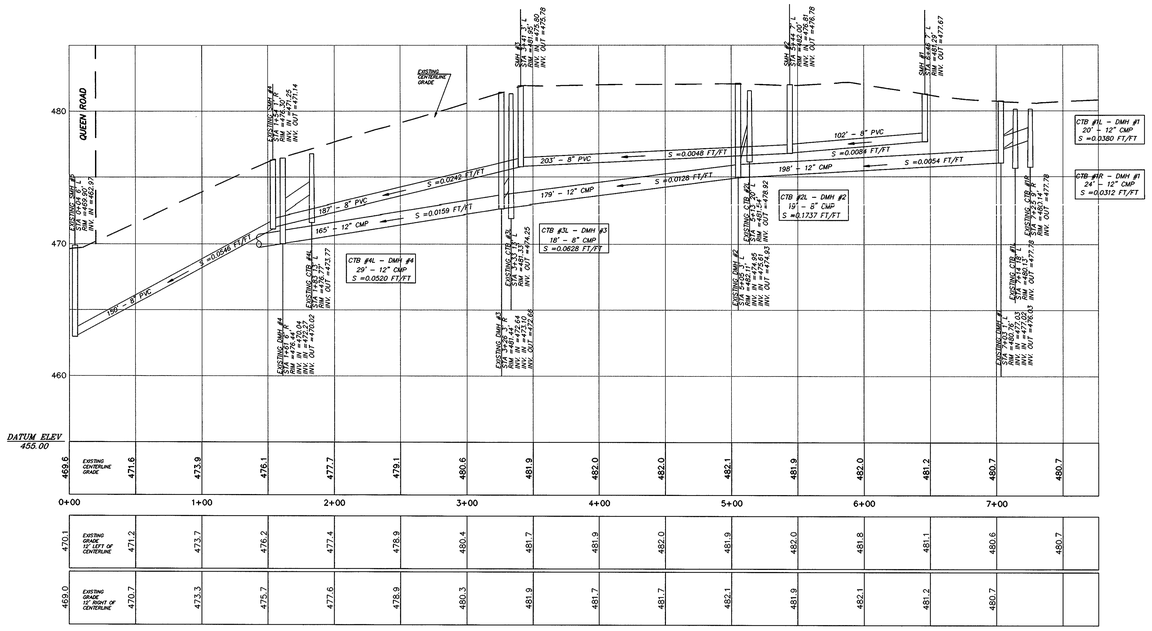


PLAN VIEW

SCALE: 1" = 40'

WILLIAM D. HANNIGAN CIVIL 16020 COMMONWEALTH OF MASSACHUSETTS

10-7-97
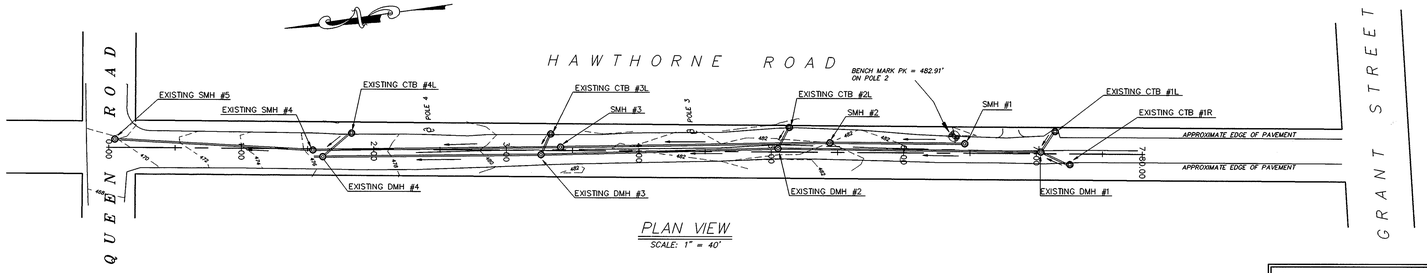
# AS-BUILT SEWER PLAN & PROFILE IN LEOMINSTER, MASSACHUSETTS

| | | |
|---|---|---|
| PREPARED FOR: NONE GLENN CHAPMAN 33 SADDLEBRED DRIVE LEOMINSTER, MA TEL: 978-534-9538 | CALC: JRR | DRWN: JRR |
| | CHKD: WDH | SCALE: 1"=40' |
| | APPD: WDH | DATE: OCT. 7, 1997 |
| DWG: LEGER2 | HANNIGAN ENGINEERING CIVIL ENGINEERS & LAND SURVEYORS 8 MONUMENT SQUARE LEOMINSTER, MASSACHUSETTS 01453 (978) 534-1234 FAX (978) 534-6060 | JOB NO: 1230 |
| SRV: GRJ | | SHEET 1 OF 1 |
| FB: BK13 PG75 | | PLAN NO: A-4-28 |

D-416