D-417

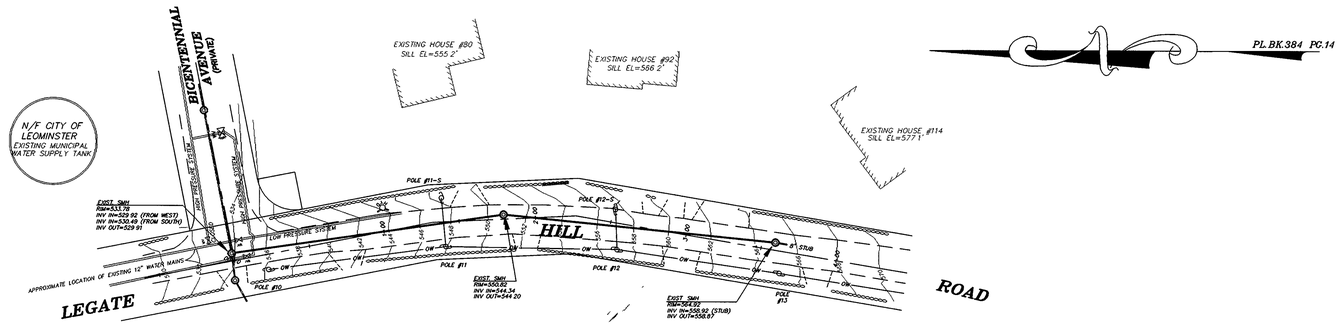

LEGATE HILL SEWER AS-BUILT PLAN

SCALE: HORIZONTAL: 1"=40'

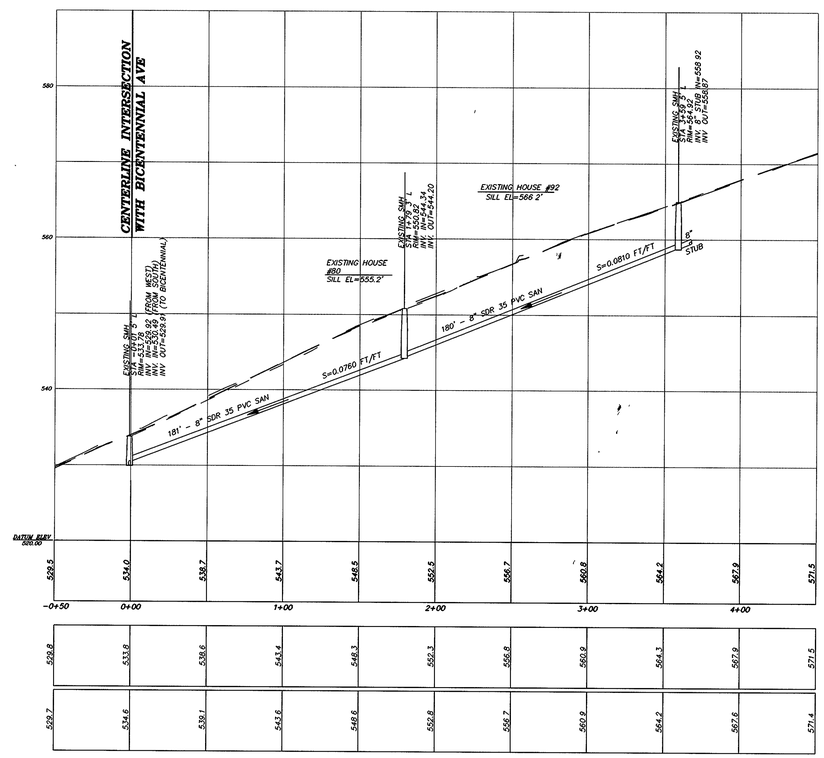

LEGATE HILL SEWER AS-BUILT PROFILE

SCALE: HORIZONTAL: 1"=40'
VERTICAL: 1"=8'

COMMONWEALTH OF MASSACHUSETTS
WILLIAM H. HANNIGAN
CIVIL
30439
REGISTERED PROFESSIONAL ENGINEER

7-11-98

AS-BUILT SEWER PROFILE IN LEOMINSTER, MASSACHUSETTS

PREPARED FOR: CITY OF LEOMINSTER, DEPARTMENT OF PUBLIC WORKS, 109 GRAHAM STREET, LEOMINSTER, MASSACHUSETTS, TEL: (978) 534-7590	CALC: JRR	DRWN: JRR
	CHKD: WDH	SCALE: AS SHOWN
	APPD: WDH	DATE: JULY 11, 1998
DWG: XAR-BAS	HANNIGAN ENGINEERING, CIVIL ENGINEERS & LAND SURVEYORS, 8 MONUMENT SQUARE, LEOMINSTER, MASSACHUSETTS 01453, (978) 534-1234 FAX (978) 534-6060	JOB NO: 1284
SRV: GRJ		SHEET 1 OF 1
FB: 14-		PLAN NO: A-2-48

D-417