D-418b

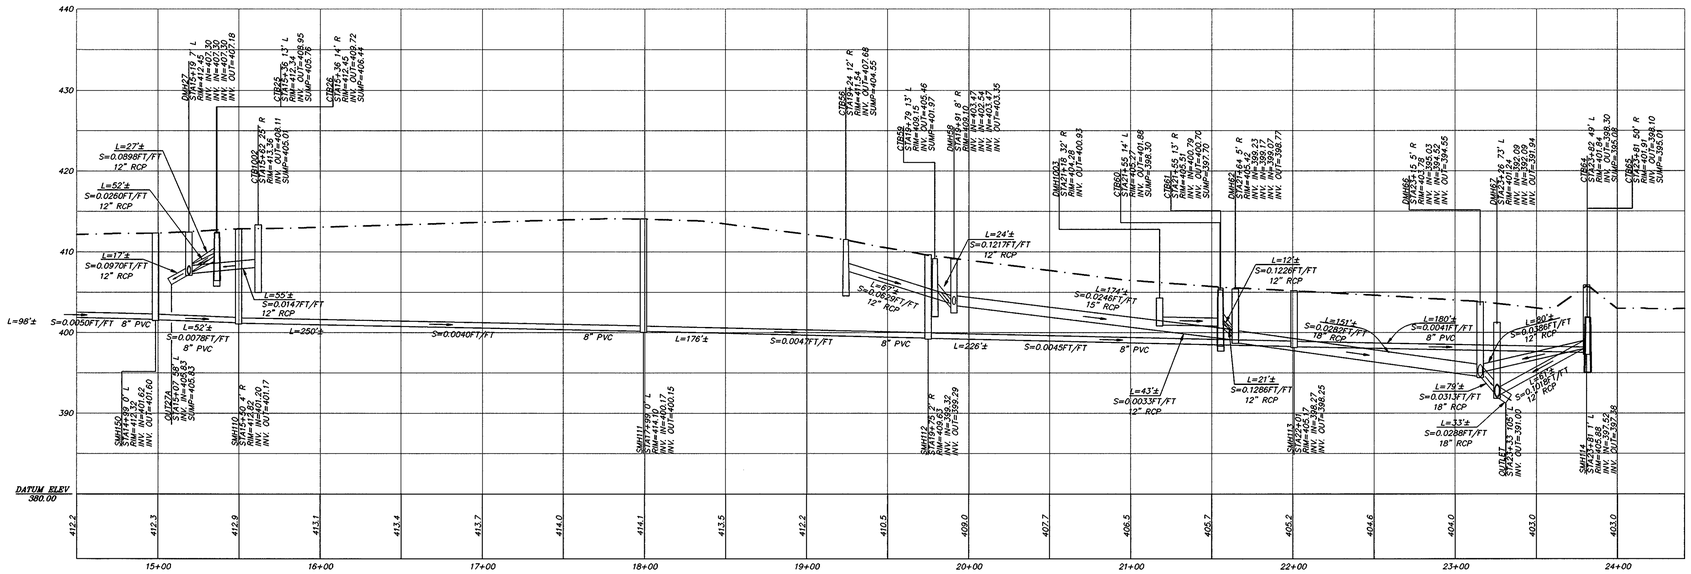

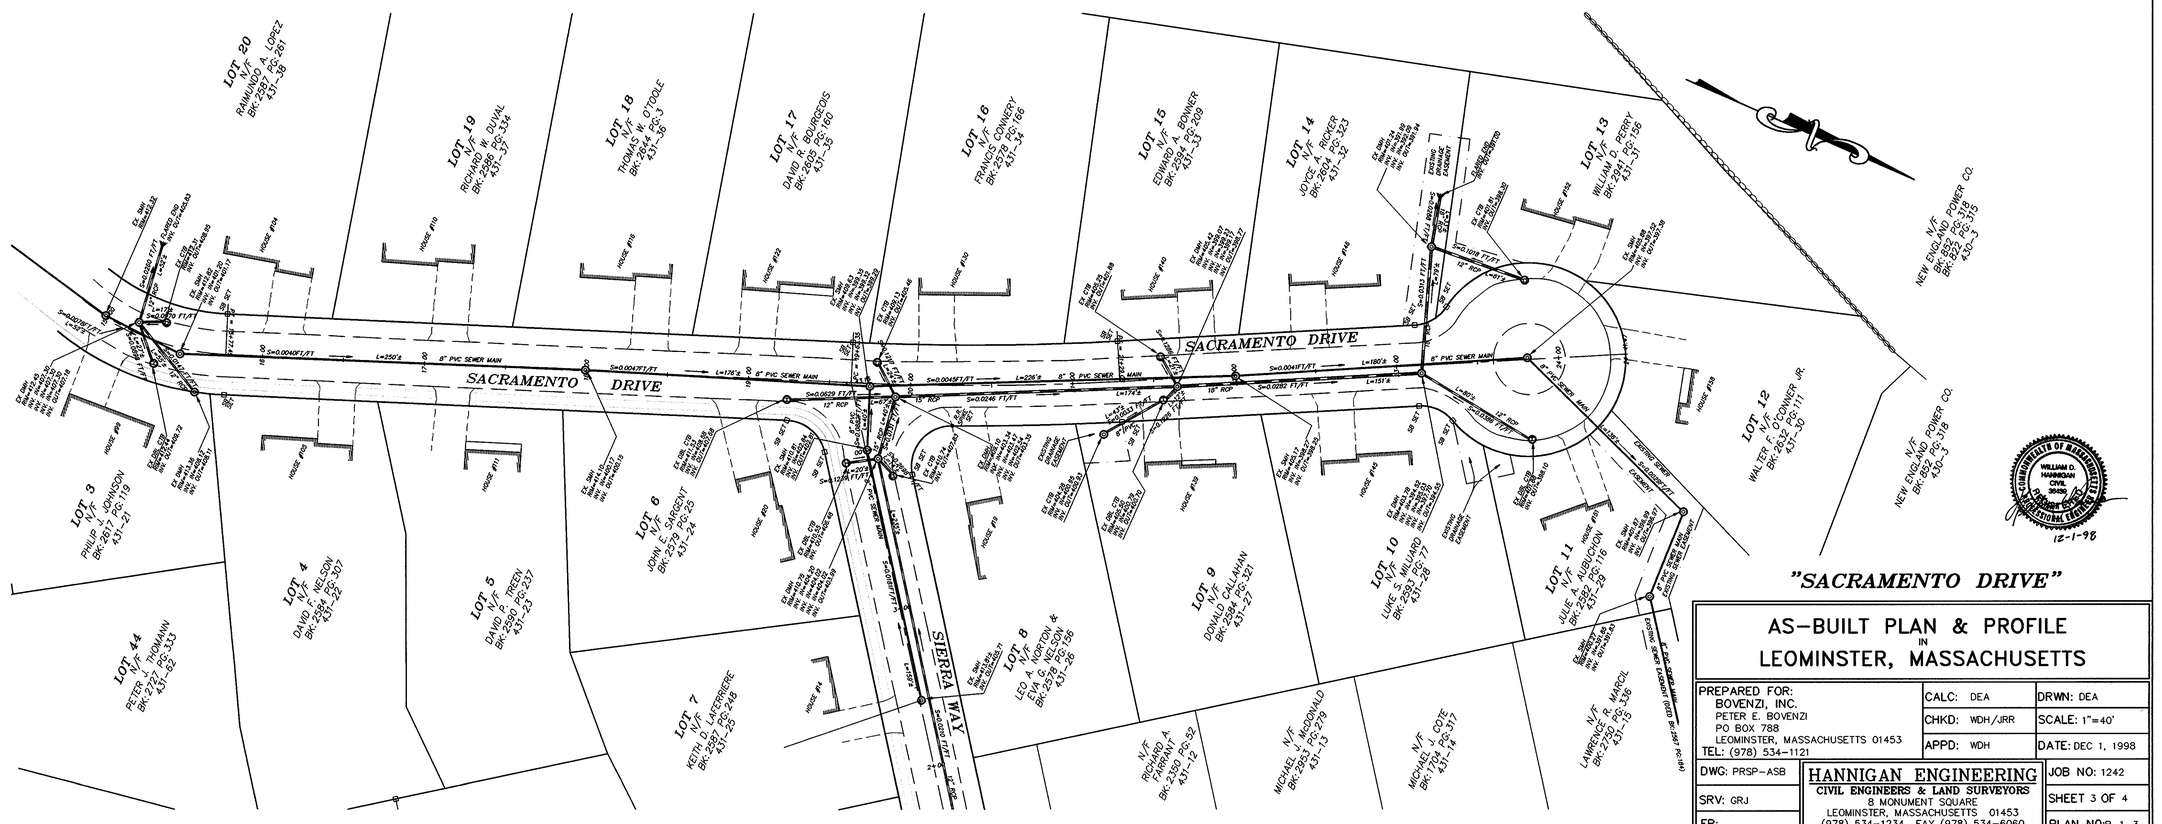

"SACRAMENTO DRIVE"

AS-BUILT PLAN & PROFILE IN LEOMINSTER, MASSACHUSETTS

PREPARED FOR: BOVENZI, INC. PETER E. BOVENZI PO BOX 788 LEOMINSTER, MASSACHUSETTS 01453 TEL: (978) 534-1121	CALC: DEA	DRWN: DEA
	CHKD: WDH/JRR	SCALE: 1"=40'
	APPD: WDH	DATE: DEC 1, 1998
DWG: PRSP-ASB	HANNIGAN ENGINEERING CIVIL ENGINEERS & LAND SURVEYORS 8 MONUMENT SQUARE LEOMINSTER, MASSACHUSETTS 01453 (978) 534-1234 FAX (978) 534-6060	JOB NO: 1242
SRV: GRJ		SHEET 3 OF 4
FB:		PLAN NO:B-1-3

D-418B