D-419

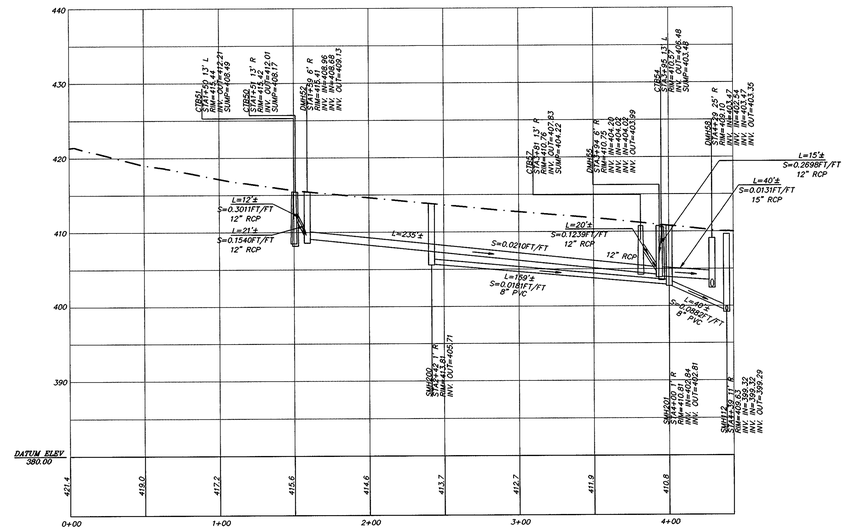

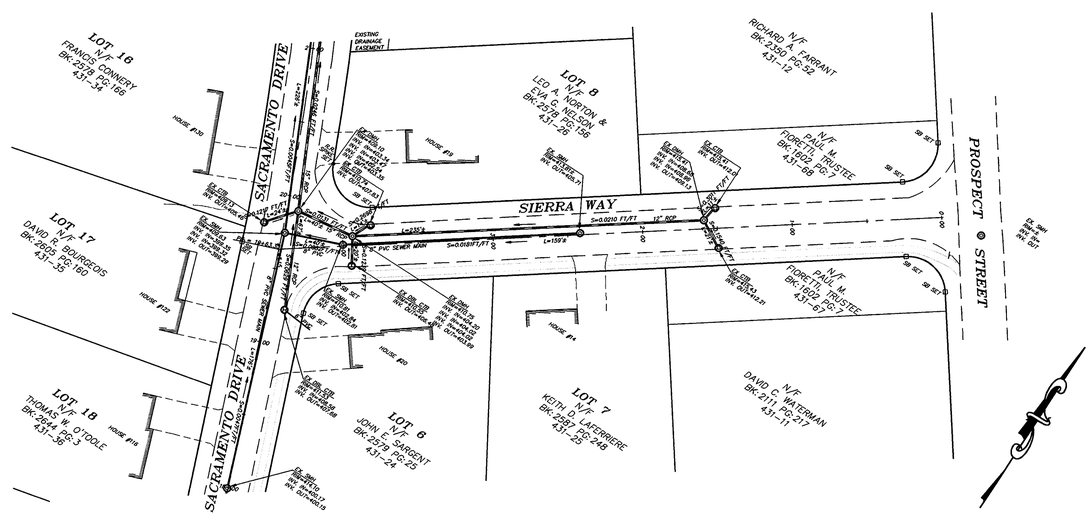

"SIERRA WAY"

AS-BUILT PLAN PROFILE
IN
LEOMINSTER, MASSACHUSETTS

PREPARED FOR: BOVENZI, INC. PETER E. BOVENZI PO BOX 788 LEOMINSTER, MASSACHUSETTS 01453 TEL: (978) 534-1121	CALC: DEA CHKD: WDH/JRR APPD: WDH	DRWN: DEA SCALE: 1"=40' DATE: DEC. 1, 1998
DWG: PRSP-ASB SRV: GRJ FB:	HANNIGAN ENGINEERING CIVIL ENGINEERS & LAND SURVEYORS 8 MONUMENT SQUARE LEOMINSTER, MASSACHUSETTS 01453 (978) 534-1234 FAX (978) 534-6060	JOB NO: 1242 SHEET 1 OF 1 PLAN NO:B-1-3