D-421c

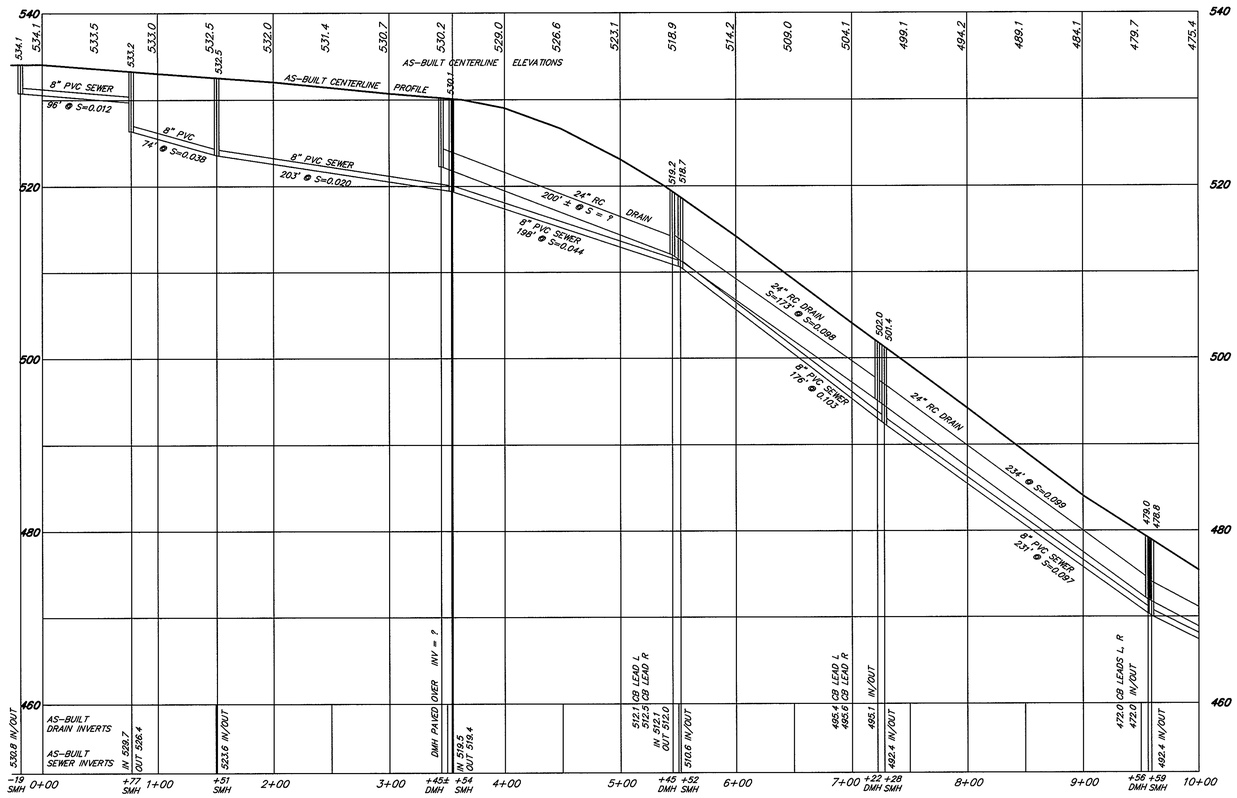

BICENTENNIAL AVENUE PROFILE
HORIZONTAL SCALE: 1" = 60'
VERTICAL SCALE: 1" = 8'

NOTE:
LOCATIONS OF UNDERGROUND SEWER SERVICES ARE BASED ON INFORMATION PROVIDED BY THE LEOMINSTER DEPARTMENT OF PUBLIC WORKS. THIS INFORMATION IS NOT WARRANTED TO BE COMPLETE OR CORRECT.

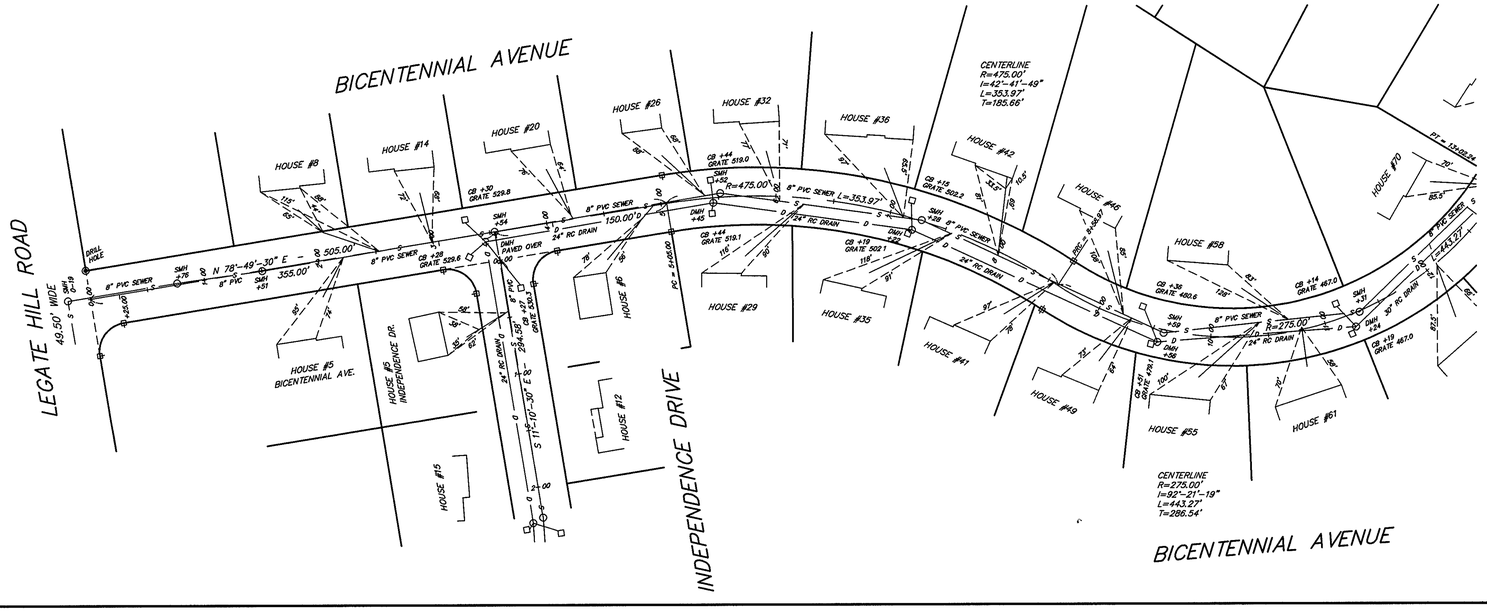

PLAN
HORIZONTAL SCALE: 1" = 60'

GRANITE BOUND SET

AS-BUILT SEWER PLAN & PROFILE OF BICENTENNIAL AVENUE & FLINTLOCK ROAD

LEOMINSTER, MASS.

OCTOBER 27, 1999

SCALES AS SHOWN

WHITMAN & BINGHAM ASSOCIATES, INC.
REGISTERED PROFESSIONAL ENGINEERS & LAND SURVEYORS
510 MECHANIC STREET – LEOMINSTER, MASSACHUSETTS 01453

SHEET 1 OF 2 SHEETS

PLAN 21-D-8

D. 421C