D-442

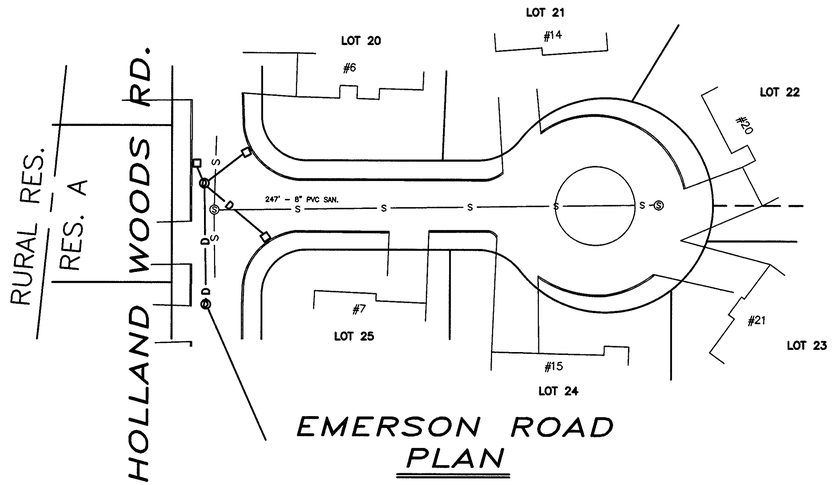

EMERSON ROAD
PLAN

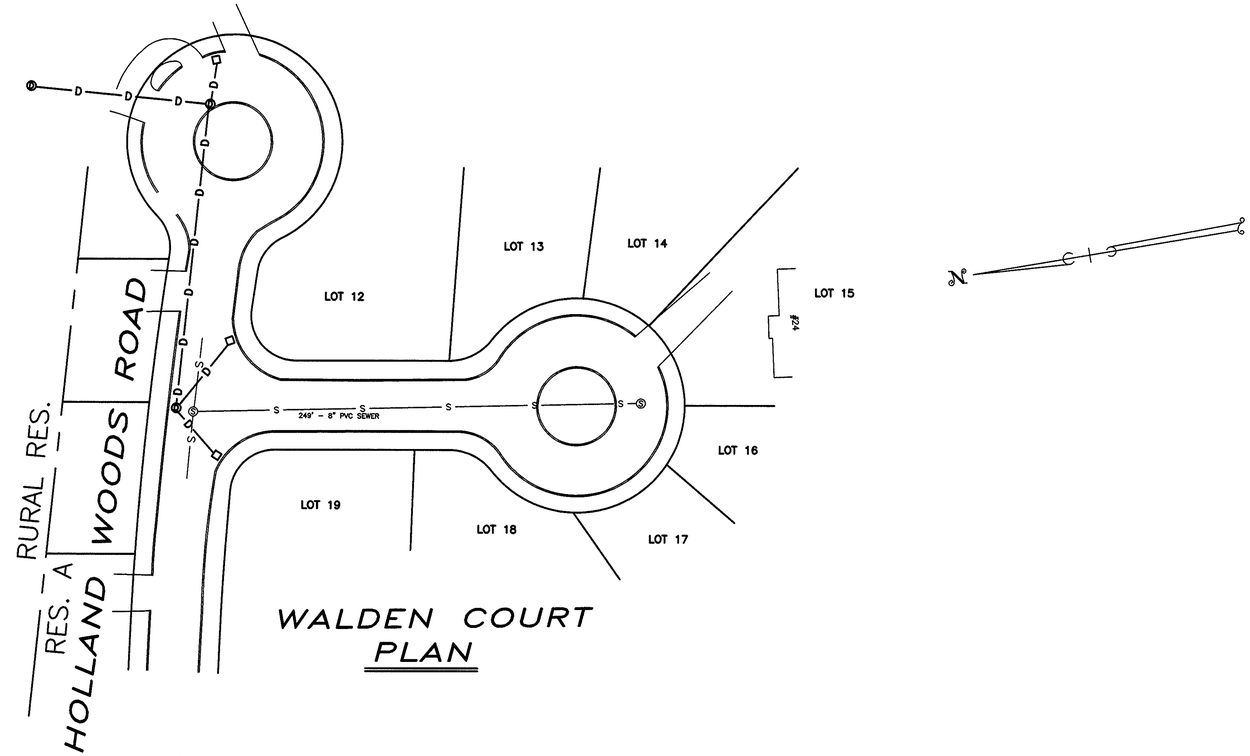

WALDEN COURT
PLAN

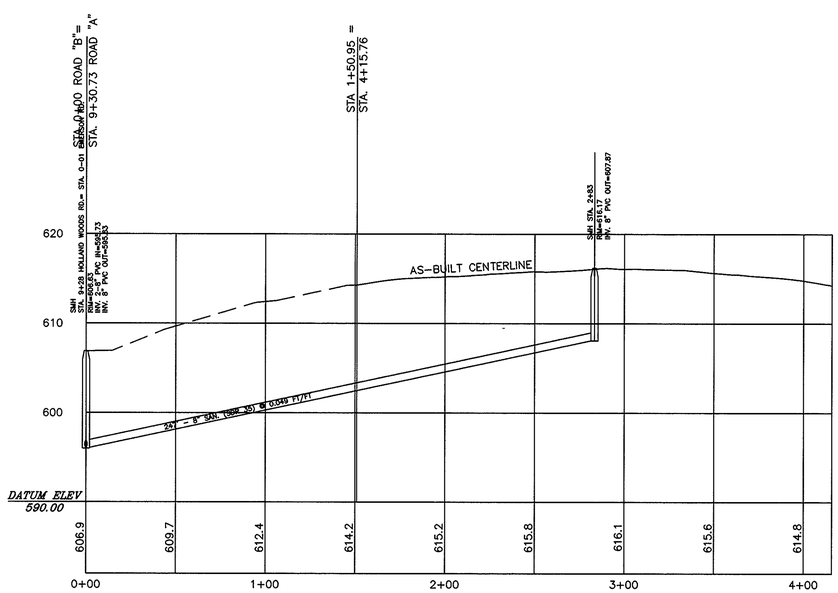

EMERSON ROAD
PROFILE

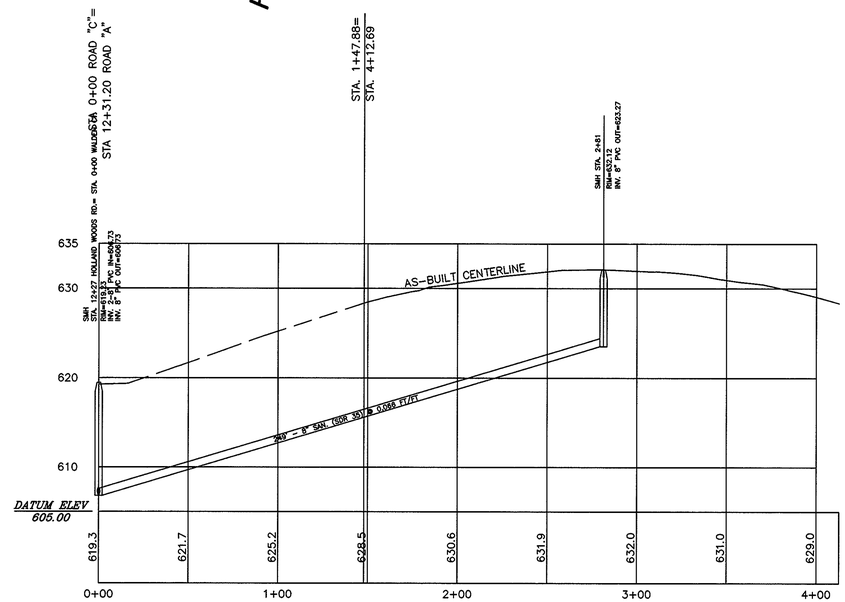

WALDEN COURT
PROFILE

SCALE: 1"=40' HORIZ. 1"=8' VERT.

HOLLAND WOODS

AS-BUILT SEWER PLAN & PROFILE

IN LEOMINSTER, MASS.

PREPARED FOR

CARTER HILL CAPITAL CORP.

MARCH 16, 1998

40 0 40 80

WHITMAN & BINGHAM ASSOCIATES, INC.
REGISTERED PROFESSIONAL ENGINEERS & LAND SURVEYORS
510 MECHANIC STREET - LEOMINSTER, MASSACHUSETTS 01453

24-D-33A

D-442